

TIPPAH
 K 2002
 6/28/79

MISSISSIPPI
 BOARD OF WATER COMMISSIONERS
 416 North State Street
 Jackson, Mississippi 39201

WATER WELL DRILLERS LOG

6 28 1979 J T Medlin Tippah
 date well completed firm name county well located

LANDOWNER: Wade Dillier
 Ripley R# 4
 Ripley Miss (mailing address)

description of formations encountered	from	to
Clay	0	40
Sand + Rock	40	180

WELL LOCATION:
 sec 3 T 4 N R 4 E
 4 1/2 miles E of Ripley
 (distance) (direction) (nearest town)

WELL PURPOSE:
 (home, irrigation, municipal, industrial)

WELL COMPLETION DATA:

(1) diameter (inches) 4
 (2) total depth (feet) 180
 (3) static water level (feet) 70 below top of ground.
 (4) casing P 180 (material) (depth)
 (size) if telescope see back.
 (5) screen 10 170 (length) (depth to top)
 4 P (size) (material)
 (6) pump 1 HP 5 (HP) (yield gpm)
 C (type power)
 (7) electric log (yes or no)
 (organization running log)

(8) how well bottom plugged
 DRILLERS REMARKS:


Miss. Board of Water Comm.

AUG 16 1979

RECEIVED

If well telescopes please sketch and show depths.

GROUND LEVEL

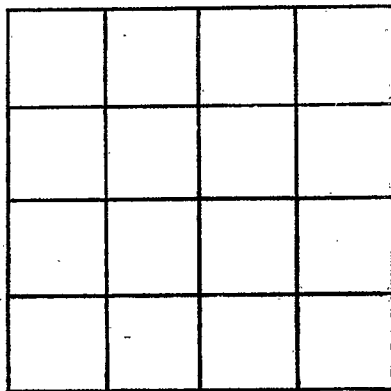

SECTION _____

Please indicate well location X.

ADDITIONAL INFORMATION

If more than one screen,
show locations of each on sketch.