

Tippecah
K. 2003
9-25-79

MISSISSIPPI
 BOARD OF WATER COMMISSIONERS
 416 North State Street
 Jackson, Mississippi 39201

WATER WELL DRILLERS LOG

9-25 19 Wilson Well Co. Tippecah
 date well completed firm name county well located

LANDOWNER:
Sam Buchanan
Rt 2 B452 Ripley Miss
 (mailing address)

description of formations encountered	from	to
<u>Red clay + Red Sand</u>	<u>0</u>	<u>30</u>
<u>Blue clay + Rock</u>	<u>30</u>	<u>60</u>
<u>Rock Blue clay</u>	<u>60</u>	<u>90</u>
<u>Sand</u>	<u>90</u>	<u>125</u>

WELL LOCATION:
 sec. 33 17 4 N 4 E
S W
 (distance) miles (direction) of (nearest town)

WELL PURPOSE:
 (home, irrigation, municipal, industrial)

- WELL COMPLETION DATA:
- (1) diameter (inches) 4
 - (2) total depth (feet) 127
 - (3) static water level (feet) 20 below above top of ground.
 - (4) casing (material) 127 (depth)
4 If telescope see back.
 (size)
 - (5) screen 10 117
 (length) (depth to top)
 (size) gravel pack (material)
 - (6) pump 3/4 10
 (HP) (yield gpm)
 - electric
 (type power)
 - (7) electric log (yes or no) _____
 (organization running log) _____
 - (8) how well bottom plugged N
plastic cap

DRILLERS REMARKS:


DEPT. OF NATURAL RESOURCES
 BUREAU OF LAND & WATER RESOURCES

JAN 7 1980

RECEIVED

If well telescopes please sketch and show depths.

GROUND LEVEL

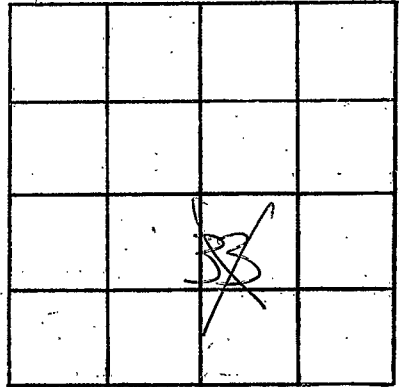

SECTION 33

Please indicate well location X.

ADDITIONAL INFORMATION

If more than one screen, show locations of each on sketch.