

TIPPAIN
K 2004
44-81

MISSISSIPPI
BOARD OF WATER COMMISSIONERS
416 North State Street
Jackson, Mississippi 39201

WATER WELL DRILLERS LOG

44-81 date well completed
J.T. Medlin firm name
Tippain county well located

John B. BUNNIFANT DOWNER
Rt 4 Ripley MS, 38663
(mailing address)

description of formations encountered	from	to
Red Clay	0	30
Rock & sand	30	170

WELL LOCATION:
sec 10 T 4 N R 4 E
3 miles NW of Cross Gro
(distance) (direction) (nearest town)

WELL PURPOSE: home irrigation, municipal, industrial

- WELL COMPLETION DATA:
- (1) diameter (inches) 4
 - (2) total depth (feet) 170
 - (3) static water level (feet) 90 below top of ground
 - (4) casing PVC, 160 (material) (depth)
 - (size) If telescope see back.
 - (5) screen 10, 160 (length) (depth to top)
 - 4 PVC (size) (material)
 - (6) pump 1/2, 10 (HP) (yield gpm)
 - Etc (type-power)
 - (7) electric log (yes or no)

(organization running log)
(8) how well bottom plugged CAP


DRILLERS REMARKS:

DEPT. OF NATURAL RESOURCES
BUREAU OF LAND & WATER RESOURCES

MAY 23 1987
RECEIVED

If well telescopes please
sketch and show depths.

GROUND LEVEL

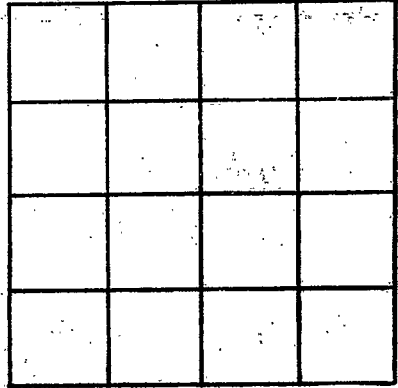

SECTION _____

Please indicate well location X.

ADDITIONAL INFORMATION

If more than one screen,
show locations of each on sketch.