

MISSISSIPPI DEPARTMENT OF NATURAL RESOURCES

Bureau of Land and Water Resources

Southport Mall

P.O. Box 10631

Jackson, Mississippi 39209

WATER WELL DRILLERS LOG

Tippah  
K2005

Feb. 17 1983  
date well completed

Wilson Well Co. Inc  
firm name

Tippah  
county well located

LANDOWNER: <u>Elmer Childres</u>	description of formations encountered	from	to
<u>403 Lilab Circle</u> <u>Ripley, Miss.</u> (mailing address)			
	<u>Blue Clay</u>	<u>30</u>	<u>60</u>
	<u>Blue Clay - Green Sand - Blue Clay</u>	<u>60</u>	<u>70</u>
	<u>Blue Clay - Rock - Blue Clay</u>	<u>70</u>	<u>90</u>
	<u>Green Sand - Rock</u>	<u>90</u>	<u>132</u>
<p>WELL LOCATION:</p> <p>sec. <u>7</u> T <u>4</u> N R. <u>4</u> E</p> <p><u>2</u> miles (distance) <u>E</u> (direction) of <u>Ripley</u> (nearest town)</p> <p>WELL PURPOSE: <u>Home</u> (home, irrigation, municipal, industrial)</p> <p>WELL COMPLETION DATA:</p> <p>(1) diameter (inches) <u>4</u></p> <p>(2) total depth (feet) <u>132</u></p> <p>(3) static water level (feet) <u>55</u> below above top of ground.</p> <p>(4) casing <u>Plastic</u>, <u>132</u>, (material) (depth)</p> <p><u>4</u> If telescope see back. (size)</p> <p>(5) screen <u>20</u>, (length) (depth to top)</p> <p><u>4</u>, <u>Plastic</u> (size) (material)</p> <p>(6) pump <u>3/4</u>, <u>8</u> (HP) (yield gpm)</p> <p><u>Electric</u> (type power)</p> <p>(7) electric log <u>No</u> (yes or no)</p> <p>(organization running log)</p> <p>(8) how well bottom plugged <u>4"</u> <u>Plastic Cap</u></p> <p>DRILLERS REMARKS:</p>			


DEPT. OF NATURAL RESOURCES  
BUREAU OF LAND & WATER RESOURCES

MAR 30 1983

RECEIVED

If well telescopes please sketch and show depths.

GROUND LEVEL

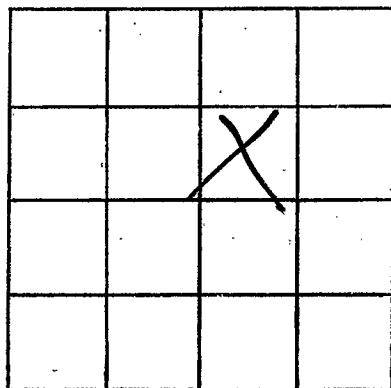

SECTION

7

Please indicate well location X.

ADDITIONAL INFORMATION

If more than one screen, ...  
show locations of each on sketch.