

MISSISSIPPI DEPARTMENT OF NATURAL RESOURCES

Bureau of Land and Water Resources

Southport Mall

P.O. Box 10631

Jackson, Mississippi 39209

WATER WELL DRILLERS LOG

Jipah
K 2007
5/25/83

5-25-83 date well completed 1983 Mulhiney firm name Kipah county well located

LANDOWNER:
Roy Barkley
Ripley MS
(mailing address)

WELL LOCATION:
sec. 12 T 4 N R 4 E
5 miles E of Ripley
(distance) (direction) (nearest town)

WELL PURPOSE:
(home, irrigation, municipal, industrial)

WELL COMPLETION DATA:

(1) diameter (inches) 4

(2) total depth (feet) 460

(3) static water level (feet) 180 below top of ground

(4) casing PVC-219 (material) (depth)

(size) if telescope see back.

(5) screen (length) (depth to top)

(size) (material)

(6) pump 1/2 (HP) 12 (yield gpm)

ELC (type power)

(7) electric log (yes or no)

(organization running log)


(8) how well bottom plugged

description of formations encountered	from	to
Sand	0	100
Clay	100	220
Clay - Rock	220	350
Concretion	350	420
Equipment	420	460

DRILLERS REMARKS:

If well telescopes please sketch and show depths.

GROUND LEVEL

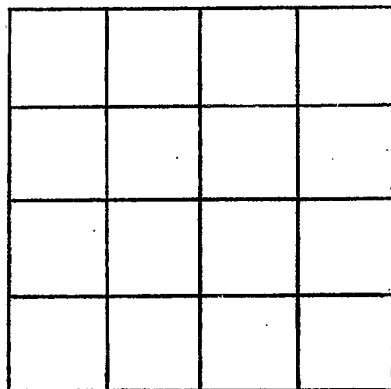

SECTION _____

Please indicate well location X.

ADDITIONAL INFORMATION

If more than one screen,
show locations of each on sketch.