

MISSISSIPPI DEPARTMENT OF NATURAL RESOURCES

Bureau of Land and Water Resources

Southport Mall

P.O. Box 10631

Jackson, Mississippi 39209

WATER WELL DRILLERS LOG

Tipphah  
K 2008

Nov. 10

1983

Wilson Well Co. Inc

Tipphah

date well completed

firm name

county well located

LANDOWNER: Lamon McClain

description of formations encountered

from

to

Rt 3

Ripley, ms. 38663  
(mailing address)

Brown Clay

0 12

Red Sand

12 32

Brown Sand-Rock

32 90

WELL LOCATION:

sec. 27 T. 4 N. R. 4 E

5 miles East of Ripley  
(distance) (direction) (nearest town)

WELL PURPOSE: Home  
(home, irrigation, municipal, industrial)

WELL COMPLETION DATA:

(1) diameter (inches) 4  
(2) total depth (feet) 90  
(3) static water level (feet) 38 below above top of ground.

(4) casing 4 90  
(material) (depth)  
4 if telescope see back.  
(size)

(5) screen 10 90  
(length) (depth to top)  
4 PLASTIC  
(size) (material)

(6) pump 1 12  
(HP) (yield gpm)  
Electric  
(type power)

(7) electric log NO  
(yes or no)

(organization running log)

(8) how well bottom plugged 4 1/2 PVC  
CAP

DEPT. OF NATURAL RESOURCES  
BUREAU OF LAND & WATER RESOURCES


DEC 19 1983

RECEIVED

DRILLERS REMARKS:

If well telescopes please sketch and show depths.

GROUND LEVEL

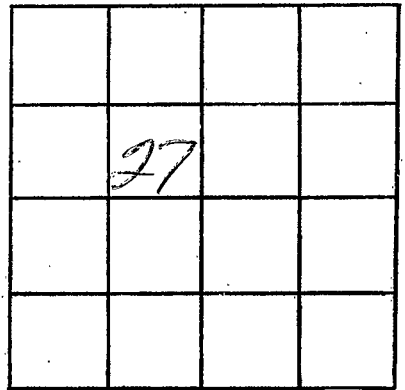

SECTION 27

Please indicate well location X.

ADDITIONAL INFORMATION

If more than one screen, show locations of each on sketch.