

TIPPANH
 L 8
 8-13-70

MISSISSIPPI
 BOARD OF WATER COMMISSIONERS
 416 North State Street
 Jackson, Mississippi 39201

CODING

WATER WELL DRILLERS LOG

Aug 13 1970 J. J. Madlin Tippah
 date well completed firm name county well located

LANDOWNER: Max Bickles
 Hwy 4 E
 Ripley
 (mailing address)

WELL LOCATION:
 sec. 28 T 4 N R. 5 E 216
 8 miles S of Ripley
 (distance) (direction) (nearest town)

WELL PURPOSE:
 (home, irrigation, municipal, industrial)

- WELL COMPLETION DATA:
- (1) diameter (inches) 5"
 - (2) total depth (feet) 500
 - (3) static water level (feet) 150 below top of ground.
 - (4) casing P 250 (material) (depth)
 2 (size) if telescope see back.
 - (5) screen 100 400 (length) (depth to top)
 2 (size) P (material)
 - (6) pump 1/2 (HP) 12 (yield gpm)
 e (type power)
 - (7) electric log (yes or no)
 (organization running log)
 - (8) how well bottom plugged Blue Clay

description of formations encountered	from	to
Red Clay	0	8
" Sand	8	24
Yellow Clay	24	31
Blue	31	36
Red Sand	36	43
Blue clay	43	60
Rock	60	67
Blue "	67	87
Rock	87	90
Blue	90	112
Sand	112	127
Blue "	127	137
Sand	137	148
Blue "	148	500


CODING

DRILLERS REMARKS:

SEP 2 1970

If well telescopes please sketch and show depths.

GROUND LEVEL

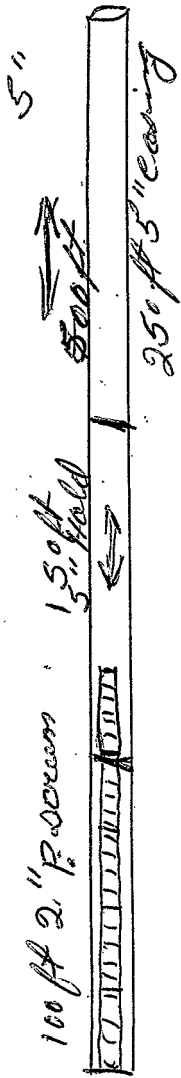

SECTION _____

Please indicate well location X.

ADDITIONAL INFORMATION

If more than one screen, show locations of each on sketch.