

MISSISSIPPI  
BOARD OF WATER COMMISSIONERS  
416 North State Street  
Jackson, Mississippi 39201

**CODED**

WATER WELL DRILLERS LOG

TIPPAH  
L 10  
8-18-70

Tippah  
Tippah

Aug 18 1970 J. W. Webb & Sons date well completed firm name county well located

LANDOWNER: Jim Parks  
Ripley Miss  
(mailing address)  
WELL LOCATION:  
sec. 19 T. 45 N R. 5 E  
7 miles East of Ripley  
(distance) (direction) (nearest town)

description of formations encountered	from	to
Soil	0	4
Red sand	4	64
Blue sand & soap	64	274
Blue Rock	274	601
Water Rock	601	603
Water sand	603	720
Coffee sand		

WELL PURPOSE:  
(home, irrigation, municipal, industrial)

WELL COMPLETION DATA:  
(1) diameter (inches) 4"  
(2) total depth (feet) 730'  
(3) static water level (feet) 197 below top of ground.  
(4) casing Steel 294'  
(material) (depth)  
4 if telescope see back.  
(size)  
(5) screen 0 0  
(length) (depth to top)  
0 0  
(size) (material)  
(6) pump 3/4 Seih 9  
(HP) (yield gpm)  
6 lec  
(type power)  
(7) electric log 0  
(yes or no)  
0  
(organization running log)  
(8) how well bottom plugged Open

**CODED**


DRILLERS REMARKS:

SEP 8 1970

MISS. BD. OF  
WATER COMM.

If well telescopes please sketch and show depths.

GROUND LEVEL

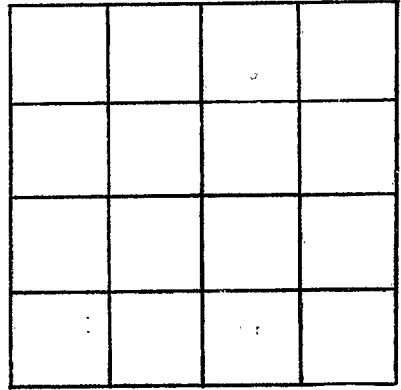

SECTION \_\_\_\_\_

Please indicate well location X.

ADDITIONAL INFORMATION

If more than one screen, show locations of each on sketch.