

MISSISSIPPI
BOARD OF WATER COMMISSIONERS
416 North State Street
Jackson, Mississippi 39201

CODED

Oct 7-3-70
cont 7/8/70

WATER WELL DRILLERS LOG

Tippah
L11
6-5-70

6-15-1970 date well completed JST Martin firm name Tippah county well located

LANDOWNER: Edward
Michael
Cooperville
(mailing address)

WELL LOCATION:
sec. 25 T 4 N R 5 E
3 miles E Jupiter
(distance) (direction) (nearest town)

description of formations encountered	from	to
sand & clay	0	9
" "	9	16
clay	16	256
rock	256	362
clay	362	371
rock	371	379
sand	379	382

WELL PURPOSE:
(home, irrigation, municipal, industrial)

WELL COMPLETION DATA:

(1) diameter (inches) 4

(2) total depth (feet) 368

(3) static water level (feet) 128 below top of ground

(4) casing P 86
(material) (depth)
(size) if telescope see back.

(5) screen None 7
(length) (depth to top)
(size) (material)

(6) pump 2 6
(HP) (yield gpm)
(type power)

(7) electric log (yes or no)
(organization running log)

(8) how well bottom plugged Blue Clay

CODED

JUL 1 1970

MISS. BD. OF
WATER COMM.

DRILLERS REMARKS:

If well telescopes please sketch and show depths.


GROUND LEVEL

86' 4" Con

207'

35' 2" Pipe

40' Slotted 2" Pipe

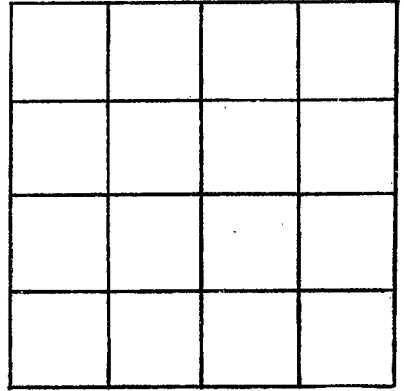

SECTION _____

Please indicate well location X.

ADDITIONAL INFORMATION

If more than one screen,
show locations of each on sketch.