

TIPPAH

L12

9-20-70

MISSISSIPPI BOARD OF WATER COMMISSIONERS
416 North State Street
Jackson, Mississippi 39201

CODED

WATER WELL DRILLERS LOG

9 20

1970

J. T. Mallin

Tippah

date well completed

firm name

county well located

LANDOWNER: T. M. James

description of formations encountered

from to

Ripley

Red CLAY

0 14

Shiloh R#
(mailing address)

" SAND

14 22

Rock "

22 118

Yellow CLAY

118 126

SAND

126 146

Rock

146 149

SAND

149 158

Yellow "

158 163

SAND

163 180

Blue

180 200

SAND

200 220

WELL LOCATION:

sec. 21 T. 4 N. R. 50 E. S. 4
4 miles NE of Poplar
(distance) (direction) (nearest town)

WELL PURPOSE:

(home, irrigation, municipal, industrial)

WELL COMPLETION DATA:

- (1) diameter (inches) 4
- (2) total depth (feet) 220
- (3) static water level (feet) 160 below top of ground.
- (4) casing P 220 (material) (depth)
- (size) If telescope see back.
- (5) screen 20 200 (length) (depth to top)
- (size) (material)
- (6) pump 1/2 3 (HP) (yield gpm)
- (type power) e
- (7) electric log (yes or no)
- (organization running log)
- (8) how well bottom plugged

CODED

OCT 7 1970


DRILLERS REMARKS:

Well was no good pump SAND. F.M.S.

MISSISSIPPI BOARD OF WATER COMMISSIONERS

If well telescopes please sketch and show depths.

GROUND LEVEL

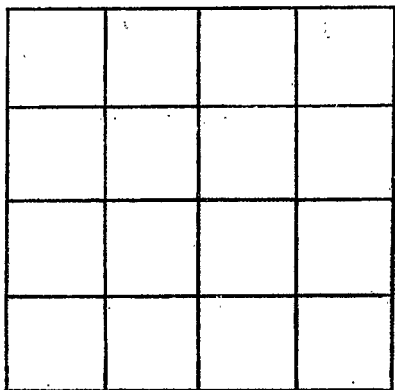

SECTION _____

Please indicate well location X.

ADDITIONAL INFORMATION

If more than one screen,
show locations of each on sketch.