

TIPPAM
L13
7-25-70

MISSISSIPPI
BOARD OF WATER COMMISSIONERS
416 North State Street
Jackson, Mississippi 39201

WATER WELL DRILLERS LOG **CODED**

7-25 date well completed 70 Bond Island Drilling Loppin county well located

LANDOWNER: Jimmy Mitchell

description of formations encountered

from to

Rippon Miss (mailing address)

~~Red sand~~
Yellow sand 0 28
Blue clay 28 56
Water sand 56 397
347 390

WELL LOCATION:

sec. 15 T. 4 N. R. 5 E

5 miles N-W of Jurgens (distance) (direction) (nearest town)

WELL PURPOSE: Home (home, irrigation, municipal, industrial)

WELL COMPLETION DATA:

- (1) diameter (inches) 4
- (2) total depth (feet) 390
- (3) static water level (feet) 190 below top of ground.

(4) casing Steel 63 (material) (depth)

(size) If telescope see back.

(5) screen Iron (length) (depth to top)

(size) (material)

(6) pump 1 1/2 (HP) 5 (yield gpm)

Elect. post (type power)

(7) electric log No (yes or no)

(organization running log)

(8) how well bottom plugged Open

CODED


AUG 11 1970

DRILLERS REMARKS:

MISS. Bd. of Water Comm. 1968

If well telescopes please sketch and show depths.

GROUND LEVEL

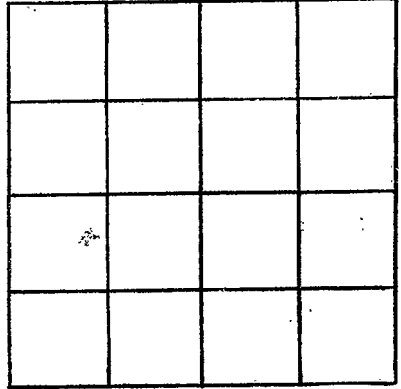

SECTION _____

Please indicate well location X.

ADDITIONAL INFORMATION

If more than one screen, show locations of each on sketch.