

TIPPAH
L 14
8-11-70

MISSISSIPPI
BOARD OF WATER COMMISSIONERS
416 North State Street
Jackson, Mississippi 39201

CODED

WATER WELL DRILLERS LOG

Aug 11 1970 J. T. Medlin Tippah
date well completed firm name county well located

LANDOWNER: T.M. James
Ripley R#
Shiloh R#
(mailing address)

WELL LOCATION:
sec. 21 T 4 N R 5 E
4 miles NE of Peoples
(distance) (direction) (nearest town)

WELL PURPOSE:
(home, irrigation, municipal, industrial)

WELL COMPLETION DATA:
(1) diameter (inches) 4
(2) total depth (feet) 180
(3) static water level (feet) 160 below top of ground.
(4) casing P 180 (material) (depth)
(size) if telescope see back.
(5) screen 20 160 (length) (depth to top)
(size) (material)
(6) pump 1/2 5 (HP) (yield gpm)
(type power)
(7) electric log (yes or no)
(organization running log)
(8) how well bottom plugged Open

description of formations encountered	from to	
Red Clay	0	14
11 sand	14	22
Rock & sand	22	118
yellow clay	118	126
sand	126	146
Rock	146	149
sand	149	158
yellow "	158	163
sand	163	180
blue	180	187


CODED

AUG 18 1970

DRILLERS REMARKS:

If well telescopes please sketch and show depths.

GROUND LEVEL

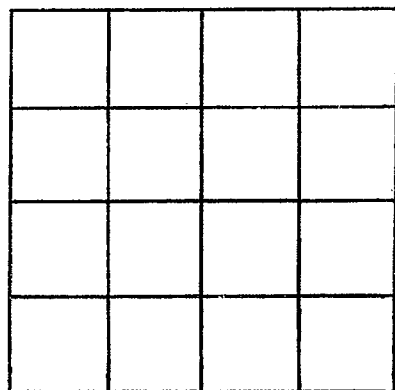

SECTION _____

Please indicate well location X.

ADDITIONAL INFORMATION

If more than one screen,
show locations of each on sketch.