

TIPPAH
L15
5-19-71

MISSISSIPPI
BOARD OF WATER COMMISSIONERS
416 North State Street
Jackson, Mississippi 39201

CODED

WATER WELL DRILLERS LOG

5-19 1971 Bonds Well Drilling Tipphah
date well completed firm name county well located

LANDOWNER: Fate Pousley
Ripley Miss
(mailing address)

description of formations encountered	from	to
Red Clay	0	17
Blue Clay	17	376
Water Sand	376	430

WELL LOCATION:
sec. 34 T-4 N R-5 E
10 miles West of Ripley
(distance) (direction) (nearest town)

WELL PURPOSE: Home
(home, irrigation, municipal, industrial)

- WELL COMPLETION DATA:
- (1) diameter (inches) 4
 - (2) total depth (feet) 430
 - (3) static water level (feet) 130 below above top of ground.
 - (4) casing Steel 21
(material) (depth)
 if telescope see back.
(size)
 - (5) screen none
(length) (depth to top)
 (size) (material).
 - (6) pump 2 5
(HP) (yield gpm)
Elect
(type power)
 - (7) electric log no
(yes or no)
 (organization running log)
 - (8) how well bottom plugged open

CODED


JUN 4 1971

DRILLERS REMARKS:

MISS. DD. OF
WATER COMMISSIONERS

If well telescopes please sketch and show depths.

GROUND LEVEL

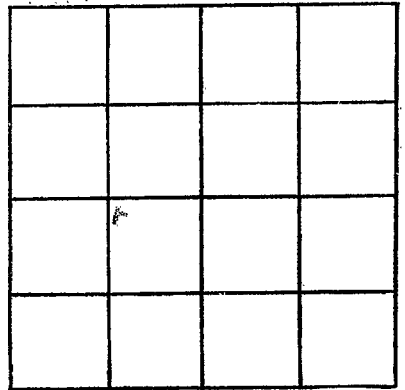

SECTION _____

Please indicate well location X.

ADDITIONAL INFORMATION

If more than one screen, show locations of each on sketch.