

TIPPAH

WATER WELL DRILLERS LOG

CODED

L 16
11-20-63

Date: Nov 20, 1963, Driller: Bob Demoy County Leflore

BOBBY GATES

(Name)

(1) Owner of Land: Bob Gates
(Name)

Poplar miss
(Address)

(2) Location: 1/4, 1/4, Sec. 16 45 SE, T. R

10 miles East of Poplar miss
(distance) (direction) (Nearest Town)

(3) Topography: X
(Hilly) (Flat) (Level)

(4) Purpose of Well: Home use
(Domestic Irrigation
Municipal, Industrial, Other)

Description & Color of Materials
Sand, Clay, Red Clay, Shell, etc.

Thick-
ness
Feet

Depth
Feet

Information upon completion of well:

(1) Diameter 4 inches.

(2) Total Depth 20 feet.

(3) Water Level 90 feet below top of ground.

(4) Cased to 108, Size 4

(5) Screen: Size 2 1/2, Length 5

(6) Were any formations sealed against pollution?


no yes, no.

If YES depth of formation 1015 Rock Soil

Why

Drillers Remarks:

CODED

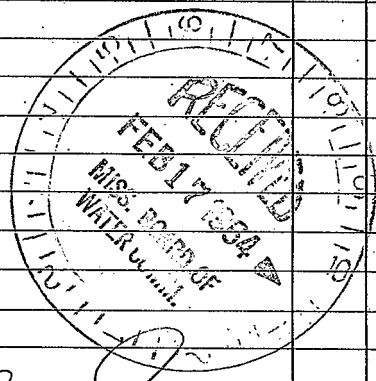

Well No.

(Use Back Side)

