

TIPPAH
L17
10-12-71

MISSISSIPPI
 BOARD OF WATER COMMISSIONERS
 416 North State Street
 Jackson, Mississippi 39201

807.50
 4250
 00

CODED

WATER WELL DRILLERS LOG

10 12 19 71 date well completed
 J T Meekins firm name
 Tippah county well located

LANDOWNER: Joe Manner
 #W. 4 E of Ripley
 (mailing address)

description of formations encountered	from	to
Clay	0	18
Sand & Blue Clay	18	140
Blue Clay	140	440
Rock + Sand	440	480

WELL LOCATION:
 sec. 26 T 4 N R 5 E
 1 1/2 miles E of Ripley
 (distance) (direction) (nearest town)

WELL PURPOSE:
 (home, irrigation, municipal, industrial)

- WELL COMPLETION DATA:
- (1) diameter (inches) 4
 - (2) total depth (feet) 480
 - (3) static water level (feet) 160 below top of ground.
 - (4) casing (material) P (depth) 140
 - 2 (size) If telescope see back.
 - (5) screen (length) 0 (depth to top)
 - (size) (material)
 - (6) pump (HP) 1/2 (yield gpm) 5
 - E (type power)
 - (7) electric log (yes or no)
 - (organization running log)
 - (8) how well bottom plugged

CODED


NOV 16 1971

MISS. BD. OF
 WATER COMM.

DRILLERS REMARKS:

If well telescopes please sketch and show depths.

GROUND LEVEL

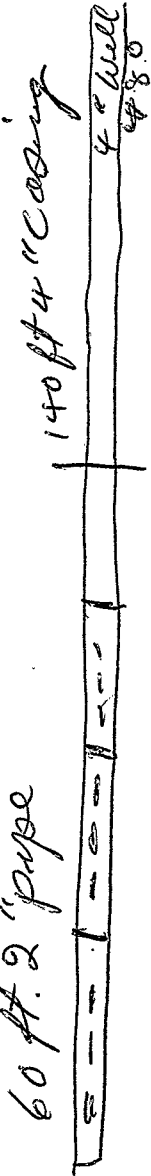

SECTION _____

Please indicate well location X.

ADDITIONAL INFORMATION

If more than one screen, show locations of each on sketch.