

MISSISSIPPI  
BOARD OF WATER COMMISSIONERS  
416 North State Street  
Jackson, Mississippi 39201

\$ 990.00  
88.09  
1028.00

WATER WELL DRILLERS LOG

**CODED**

TIPPAH  
L 18  
10-20-72

20 1972 J T Madlin TIPPAH  
date well completed firm name county well located


LANDOWNER:	description of formations encountered	from	to
Fred Eaton	Clay	0	10
H.W. & E. of Ripley	Sand	10	32
(mailing address)	blue clay	32	310
	Sand	310	380
WELL LOCATION:			
sec. 7 T. 4 N. R. 5 E.			
4 miles N of DONALD MAUNEY Grocery			
(distance) (direction) (nearest town)			
WELL PURPOSE:			
(home, irrigation, municipal, industrial)			
WELL COMPLETION DATA:			
(1) diameter (inches) 4 3/8			
(2) total depth (feet) 380			
(3) static water level (feet) 22 below top of ground			
(4) casing P 380 (material) (depth)			
(size) if telescope see back.			
(5) screen 10 370 (length) (depth to top)			
4 P (size) (material)			
(6) pump 1 1/2 6 (HP) (yield gpm)			
E (type power)			
(7) electric log (yes or no)			
(organization running log)			
(8) how well bottom plugged			
DRILLERS REMARKS:			

**CODED**

NOV 10 1972

If well telescopes please sketch and show depths.

GROUND LEVEL

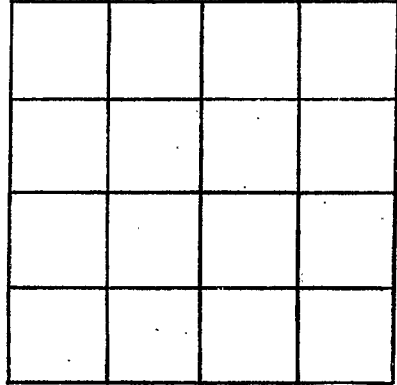

SECTION \_\_\_\_\_

Please indicate well location X.

ADDITIONAL INFORMATION

If more than one screen,  
show locations of each on sketch.