

TIPPAH  
L 19  
5-5-73

MISSISSIPPI  
BOARD OF WATER COMMISSIONERS  
416 North State Street  
Jackson, Mississippi 39201

**CODED**

WATER WELL DRILLERS LOG

5-5 1973 Bond Well Drilling Tipphah  
date well completed firm name county/well located

LANDOWNER: Willy Stroupe  
Ripley Miss  
(mailing address)

| description of formations encountered | from       | to         |
|---------------------------------------|------------|------------|
| <u>Red Clay</u>                       | <u>0</u>   | <u>16</u>  |
| <u>Blue Clay</u>                      | <u>16</u>  | <u>400</u> |
| <u>Water Sand</u>                     | <u>400</u> | <u>453</u> |

WELL LOCATION:  
sec. 34 T 4 N R 5 E  
4 miles West of Amory  
(distance) (direction) (nearest town)

WELL PURPOSE: farm  
(home, irrigation, municipal, industrial)

- WELL COMPLETION DATA:
- (1) diameter (inches) 4
  - (2) total depth (feet) 453
  - (3) static water level (feet) 120 below/above top of ground.
  - (4) casing Steel 21  
(material) (depth)  
       if telescope see back.  
(size)
  - (5) screen none  
(length) (depth to top)  
       (size)        (material)
  - (6) pump 2 5  
(HP) (yield gpm)  
split  
(type power)
  - (7) electric log no  
(yes or no)  
       (organization running log)
  - (8) how well bottom plugged open


**CODED**

DRILLERS REMARKS:

JUN 6 1973

If well telescopes please sketch and show depths.

GROUND LEVEL

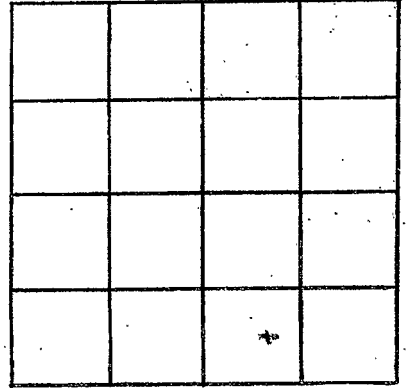

SECTION \_\_\_\_\_

Please indicate well location X.

ADDITIONAL INFORMATION

If more than one screen, show locations of each on sketch.