

CODED

MISSISSIPPI
BOARD OF WATER COMMISSIONERS
416 North State Street
Jackson, Mississippi 39201

WATER WELL DRILLERS LOG

TIPPAAH
L 20
7-19-73

7-19 1973 Bonds Well Drilling Tippah
date well completed firm name county well located

LANDOWNER: Don Mauney
Ripley, Miss.
(mailing address)

description of formations encountered	from	to
Red Clay	0	12'
White Sand	12	35
Blue Clay	35	380
Water Sand	380	430

WELL LOCATION:
sec 22 T 4 N R 5 E
11 miles W of Booneville
(distance) (direction) (nearest town)

WELL PURPOSE: Home
(home, irrigation, municipal, industrial)

- WELL COMPLETION DATA:
- (1) diameter (inches) 4"
 - (2) total depth (feet) 430
 - (3) static water level (feet) 135 ^{below}/_{above} top of ground.
 - (4) casing Steel, 42' (material) (depth)
If telescope see back. (size)
 - (5) screen None (length) (depth to top)
(size) (material)
 - (6) pump 2hp 5 (HP) (yield gpm)
Elec. (type power)
 - (7) electric log NO (yes or no)
(organization running log)
 - (8) how well bottom plugged open


CODED

DRILLERS REMARKS:

AUG 9 1973

If well telescopes please sketch and show depths.

GROUND LEVEL

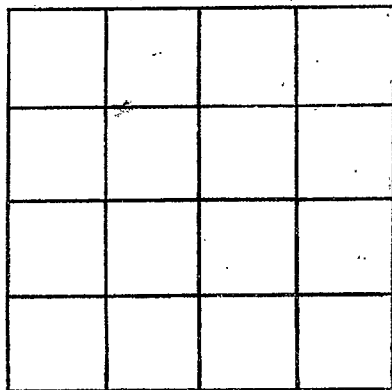

SECTION _____

Please indicate well location X.

ADDITIONAL INFORMATION

If more than one screen,
show locations of each on sketch.