

TIPPAN  
L21  
8-23-73

MISSISSIPPI  
BOARD OF WATER COMMISSIONERS  
416 North State Street  
Jackson, Mississippi 39201

COBET 19 1973

WATER WELL DRILLERS LOG

MISS. BD. OF  
WATER COMM


8-23 1973 Bonds Well Drilling Tippah  
date well completed firm name county well located

LANDOWNER:	description of formations encountered	from	to
B. W. Lawson Booneville, Miss. (mailing address)			
WELL LOCATION: sec. <u>11</u> T. <u>4</u> N R. <u>5</u> E <u>6</u> miles <u>W</u> of <u>Jungstown</u> (distance) (direction) (nearest town)			
WELL PURPOSE: <u>Home</u> (home, irrigation, municipal, industrial)			
WELL COMPLETION DATA: (1) diameter (inches) <u>4</u> (2) total depth (feet) <u>378</u> (3) static water level (feet) <u>160</u> <u>below</u> above top of ground. (4) casing <u>Steel</u> <u>6 1/2'</u> (material) (depth) _____ If telescope see back. (size) (5) screen <u>None</u> (length) (depth to top) _____ (size) _____ (material) (6) pump <u>2</u> <u>5</u> (HP) (yield gpm) <u>elec.</u> (type power) (7) electric log <u>no</u> (yes or no) _____ (organization running log) (8) how well bottom plugged <u>open</u>			
DRILLERS REMARKS:			

COBET

If well telescopes please sketch and show depths.

GROUND LEVEL

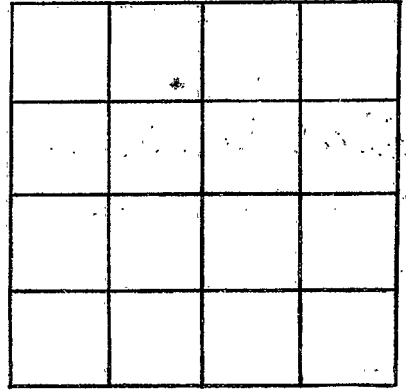

SECTION \_\_\_\_\_

Please indicate well location X.

ADDITIONAL INFORMATION

If more than one screen, show locations of each on sketch.