

Tippah  
 172  
 6-11-74

MISSISSIPPI  
 BOARD OF WATER COMMISSIONERS  
 416 North State Street  
 Jackson, Mississippi 39201

CODED

WATER WELL DRILLERS LOG

6-11-1974 date well completed      Bonds Well Drilling firm name      Tippah county well located

LANDOWNER: W.C. Alexander  
Rigley, Miss.  
 (mailing address)

description of formations encountered	from	to
Red clay	0	16
Blue sand	16	58
Water Sand	58	97

WELL LOCATION:  
 sec 13 T 4 N R 5 E  
15 miles West of Boonville  
 (distance) (direction) (nearest town)

WELL PURPOSE: Home  
 (home, irrigation, municipal, industrial)

CODED

- WELL COMPLETION DATA:
- (1) diameter (inches) 4"
  - (2) total depth (feet) 97
  - (3) static water level (feet) 43 <sup>below</sup>/<sub>above</sub> top of ground.
  - (4) casing Plastic, 97  
 (material) (depth)  
 (size) If telescope see back.
  - (5) screen Perforated Pipe  
 (length) (depth to top)  
4", Plastic  
 (size) (material)
  - (6) pump 3/4 10  
 (HP) (yield gpm)  
sub  
 (type power)
  - (7) electric log NO  
 (yes or no)
  - (8) how well bottom plugged plugged

RECEIVED  
 RECORDS


JUN 26 1974

DRILLERS REMARKS:

MISS. BD. OF WATER COMMISSIONERS

If well telescopes please sketch and show depths.

GROUND LEVEL

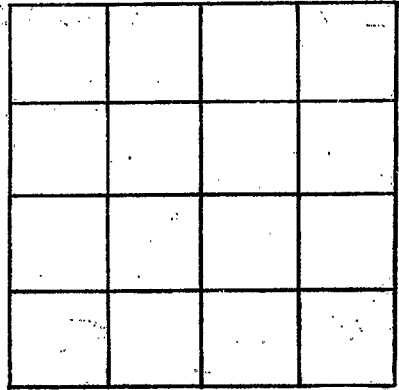

SECTION \_\_\_\_\_

Please indicate well location X.

ADDITIONAL INFORMATION

A series of horizontal lines for recording additional information, starting below the 'ADDITIONAL INFORMATION' header and extending to the bottom of the page.

If more than one screen, show locations of each on sketch.