

TIPPAN
L 24
10-9-74

MISSISSIPPI
BOARD OF WATER COMMISSIONERS
416 North State Street
Jackson, Mississippi 39201

CODED

WATER WELL DRILLERS LOG

Oct 9 1974 J F Weller Tippah
date well completed firm name county well located

LANDOWNER:	description of formations encountered	from	to
Coomb's Dr	clay	0	20
Ripley P	rock & sand	20	150
(mailing address)			

WELL LOCATION:
sec 5 T 4 N R 30 E
5 miles E of Ripley
(distance) (direction) (nearest town)

WELL PURPOSE:
(home, irrigation, municipal, industrial)

CODED


- WELL COMPLETION DATA:
- (1) diameter (inches) 4
 - (2) total depth (feet) 150
 - (3) static water level (feet) 90 below above top of ground.
 - (4) casing P 150 (material) (depth)
 - (size) If telescope see back.
 - (5) screen 10 140 (length) (depth to top)
 - 4 P (size) (material)
 - (6) pump 5 6 (HP) (yield gpm)
 - E (type power)
 - (7) electric log (yes or no)
 - (organization running log)
 - (8) how well bottom plugged Cap

DRILLERS REMARKS:

RECEIVED
DEC 18 1974

If well telescopes please sketch and show depths.

GROUND LEVEL

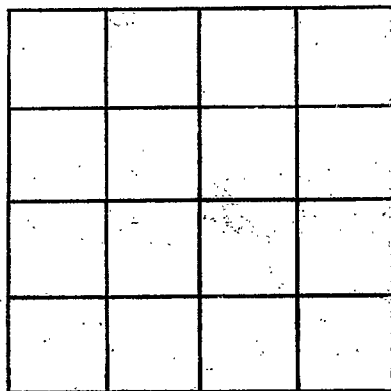

SECTION _____

Please indicate well location X.

ADDITIONAL INFORMATION

If more than one screen, show locations of each on sketch.