

TIPPAH

2000 L

5-3-77

MISSISSIPPI
 BOARD OF WATER COMMISSIONERS
 416 North State Street
 Jackson, Mississippi 39201

WATER WELL DRILLERS LOG

5-3 1977 Bomb Well Drilling Tippah
 date well completed firm name county well located

LANDOWNER: <u>Newa Stokes</u> <u>Ripley</u> (mailing address)	description of formations encountered	from	to
		<u>Red Clay</u>	0
	<u>Yellow Sand</u>	20	70
	<u>Blue Clay</u>	70	330
	<u>Water Sand</u>	330	393

WELL LOCATION:

sec 14 T 4 N R 5 E
 3 miles W of Jumpertown
 (distance) (direction) (nearest town)

WELL PURPOSE: Home
 (home, irrigation, municipal, industrial)

WELL COMPLETION DATA:

- (1) diameter (inches) 4"
- (2) total depth (feet) 393
- (3) static water level (feet) 80 ^{below} top of ground.

(4) casing P. Plastic 80
 (material) (depth)

(size) If telescope see back.

(5) screen no
 (length) (depth to top)

(size) (material)

(6) pump 2 5 gpm
 (HP) (yield gpm)

elect
 (type power)

(7) electric log no
 (yes or no)

(organization running log)

(8) how well bottom plugged open


DRILLERS REMARKS:

RECEIVED
 DEC - 7 1978

MISS. BD. OF WATER COMM.

If well telescopes please sketch and show depths.

GROUND LEVEL

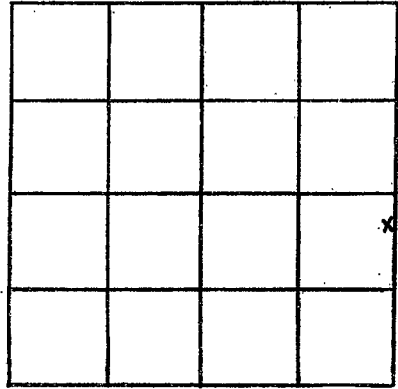

SECTION _____

Please indicate well location X.

ADDITIONAL INFORMATION

If more than one screen,
show locations of each on sketch.