

TIPPAH

L 2001

10-1-78

MISSISSIPPI BOARD OF WATER COMMISSIONERS 416 North State Street Jackson, Mississippi 39201

WATER WELL DRILLERS LOG

10-1-1978 Bond Well Drilling date well completed firm name Tippah county well located

LANDOWNER: Ken Walker

Ripley

(mailing address)

WELL LOCATION:

sec. 33 T 4 N R 5 E

6 miles W of Pump town (distance) (direction) (nearest town)

WELL PURPOSE: Home (home, irrigation, municipal, industrial)

WELL COMPLETION DATA:

- (1) diameter (inches) 4"
(2) total depth (feet) 135'
(3) static water level (feet) 60' below top of ground.
(4) casing 1 1/2" (material) 135' (depth)
(5) screen 135' (length) (depth to top)
(6) pump 1 1/2 (HP) 5000 (yibld gpm)
(7) electric log no (yes or no)
(8) how well bottom plugged plugged

Table with 3 columns: description of formations encountered, from, to. Rows include Red Clay, Yellow Sand, and Water Sand.

DRILLERS REMARKS:


RECEIVED stamp

DEC - 5 1978

MISS. BD. OF WATER COMMISSIONERS

If well telescopes please sketch and show depths.

GROUND LEVEL

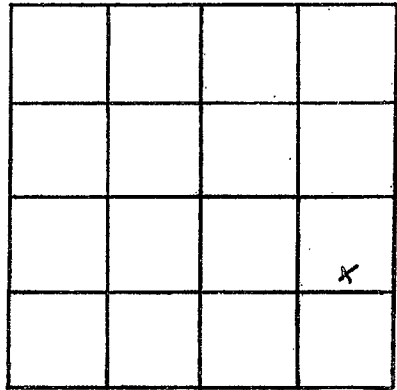

SECTION _____

Please indicate well location X.

ADDITIONAL INFORMATION

If more than one screen,
show locations of each on sketch.