

TIPPAH

L 2003

7-29-78

MISSISSIPPI BOARD OF WATER COMMISSIONERS 416 North State Street Jackson, Mississippi 39201

WATER WELL DRILLERS LOG

7-29 1978 Bonds Well Drilling Tippah date well completed firm name county well located

LANDOWNER: Bob Hale

Corinth

(mailing address)

WELL LOCATION:

sec. 4 T 4 N R 5 E 10 miles SW of Kosuth (distance) (direction) (nearest town)

WELL PURPOSE: Home (home, irrigation, municipal, industrial)

WELL COMPLETION DATA:


- (1) diameter (inches) 4"
(2) total depth (feet) 390'
(3) static water level (feet) 100 below above top of ground.
(4) casing Plastic 60' (material) (depth)
(5) screen no (length) (depth to top)
(6) pump 3/4 10 gpm (HP) (yield gpm) elect (type power)
(7) electric log no (yes or no)
(8) how well bottom plugged open

description of formations encountered

from to

Table with 3 columns: description of formations encountered, from, to. Rows include Red Clay (0-10), Yellow sand (10-50), Blue Clay (50-330), Water sand (330-390).


DRILLERS REMARKS:

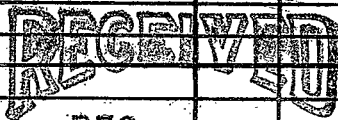

DEC - 5 1978

If well telescopes please sketch and show depths.

GROUND LEVEL

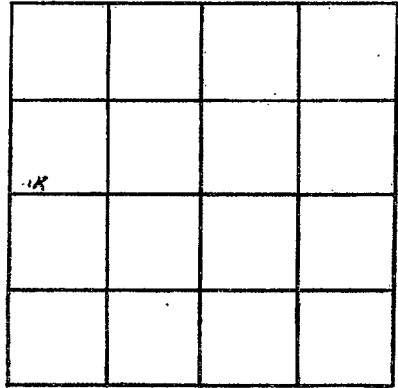

SECTION _____

Please indicate well location X.

ADDITIONAL INFORMATION

If more than one screen, show locations of each on sketch.