

TIPPAH

L 2004

8-27-78

MISSISSIPPI
 BOARD OF WATER COMMISSIONERS
 416 North State Street
 Jackson, Mississippi 39201

WATER WELL DRILLERS LOG

8-27 1978 Bonds Well Drilling Tippah
 date well completed firm name county well located

LANDOWNER: Bonnie Mauney

Jumpertown

(mailing address)

description of formations encountered

from

to

Red Clay	0	20
Yellow Sand	20	90
Blue Clay	90	120
Water sand	120	170

WELL LOCATION:

sec 15 T 4 N R 5 E
 S miles W of Jumpertown
 (distance) (direction) (nearest town)

WELL PURPOSE: Home
 (home, irrigation, municipal, industrial)

WELL COMPLETION DATA:

- (1) diameter (inches) 4"
- (2) total depth (feet) 170
- (3) static water level (feet) 90 below top of ground.
- (4) casing Plastic, 100 (material) (depth)
 (size) If telescope see back.
- (5) screen no (length) (depth to top)
 (size) (material)
- (6) pump 3/4 (HP) 10 gpm (yield gpm)
 elect (type power)
- (7) electric log no (yes or no)
 (organization running log)
- (8) how well bottom plugged open


DRILLERS REMARKS:

RECEIVED
 DEC - 5 1978

MISS. BD. OF WATER COMMISSIONERS

If well telescopes please sketch and show depths.

GROUND LEVEL

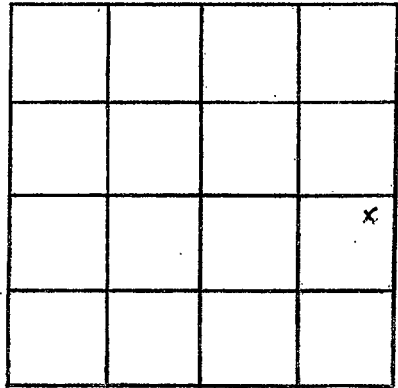

SECTION _____

Please indicate well location X.

ADDITIONAL INFORMATION

If more than one screen,
show locations of each on sketch.