

Tippah
 L 2000
 5-10-79

MISSISSIPPI
 BOARD OF WATER COMMISSIONERS
 416 North State Street
 Jackson, Mississippi 39201

WATER WELL DRILLERS LOG

5-10 1979 Bond Well Drilling Tippah
 date well completed firm name county well located

LANDOWNER: Donald L. Brock	description of formations encountered	from	to
Ripley (mailing address)	Red clay Yellow sand Water sand	0 40 60	40 60 107
WELL LOCATION:			
sec. 26 T. 4 N R. 5 E			
7 miles W of Bonnetville (distance) (direction) (nearest town)			
WELL PURPOSE: Home (home, irrigation, municipal, industrial)			
WELL COMPLETION DATA:			
(1) diameter (inches) 4"			
(2) total depth (feet) 107			
(3) static water level (feet) 50 ^{below} top of ground.			
(4) casing Plastic, 107 (material) (depth)			
_____ If telescope see back. (size)			
(5) screen Perforated, 107 (length) (depth to top)			
4 plastic (size) (material)			
(6) pump 3/4 10 (HP) (yield gpm)			
submersible (type power)			
(7) electric log no (yes or no)			
_____ (organization running log)			
(8) how well bottom plugged plugged			
DRILLERS REMARKS:			


Miss. Board of Water Comm.

JUN - 6 1979

RECEIVED

If well telescopes please sketch and show depths.

GROUND LEVEL

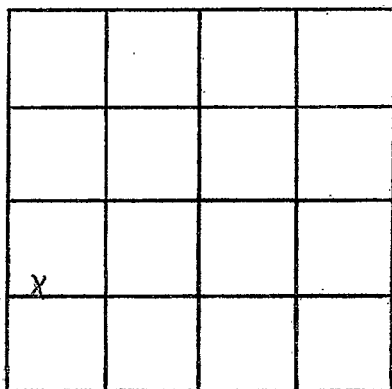

SECTION _____

Please indicate well location X.

ADDITIONAL INFORMATION

If more than one screen,
show locations of each on sketch.