

Tippah  
L 2007  
4/21/80

MISSISSIPPI  
BOARD OF WATER COMMISSIONERS  
416 North State Street  
Jackson, Mississippi 39201

WATER WELL DRILLERS LOG

4-21-80  
date well completed

1980 ~~Bomb~~ Bomb Well Drilling  
firm name

Tippah  
county well located

LANDOWNER: Gary Jewell

description of formations encountered

from

to

Ripley, Mo.

(mailing address)

Red clay	0	20
White sand	20	30
Blue clay	30	400
Water Sand	400	451

WELL LOCATION:

sec. 19 T. 4 N R. 5 E  
 5 miles East of Ripley  
 (distance) (direction) (nearest town)

WELL PURPOSE: Home  
 (home, irrigation, municipal, industrial)

WELL COMPLETION DATA:

- (1) diameter (inches) 2 1/4"
- (2) total depth (feet) 451
- (3) static water level (feet) 200 <sup>below</sup>/<sub>above</sub> top of ground.
- (4) casing plastic 40"  
 (material) (depth)  
 (size) If telescope see back.
- (5) screen \_\_\_\_\_  
 (length) (depth to top)  
 (size) (material)
- (6) pump 3/4 10  
 (HP) (yield gpm)  
 (type power)
- (7) electric log no  
 (yes or no)  
 (organization running log)
- (8) how well bottom plugged open

DRILLERS REMARKS:


DEPT. OF NATURAL RESOURCES  
BUREAU OF LAND & WATER RESOURCES

AUG 21 1980

RECEIVED

If well telescopes please sketch and show depths.

GROUND LEVEL

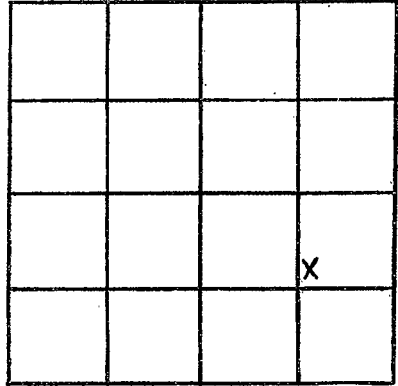

SECTION \_\_\_\_\_

Please indicate well location X.

ADDITIONAL INFORMATION

If more than one screen, show locations of each on sketch.