

MISSISSIPPI DEPARTMENT OF NATURAL RESOURCES

Bureau of Land and Water Resources

Southport Mall

P.O. Box 10631

Jackson, Mississippi 39209

WATER WELL DRILLERS LOG

Jippan  
L  
2010

5.12 1984 Medlin Jippan  
 date well completed firm name county/well located

LANDOWNER:  
Joe Mauney  
Ripley  
 (mailing address)

description of formations encountered	from	to
<u>Topsoil + Clay</u>	<u>0</u>	<u>90</u>
<u>Clay + Limestone</u>	<u>90</u>	<u>210'</u>
<u>Aquifer</u>	<u>210</u>	<u>220</u>

WELL LOCATION:  
 sec. 23 T. 4 R. 5 E  
8 miles East of Ripley  
 (distance) (direction) (nearest town)

WELL PURPOSE:  
 (home) Irrigation, municipal, industrial

WELL COMPLETION DATA:

(1) diameter (inches) 4"

(2) total depth (feet) 220'

(3) static water level (feet) 40' below above top of ground.

(4) casing PVC 160'  
 (material) (depth)

\_\_\_\_\_ if telescope see back.  
 (size)

(5) screen \_\_\_\_\_  
 (length) (depth to top)

\_\_\_\_\_ (size) \_\_\_\_\_ (material)  
 (6) pump 3/4 11  
 (HP) (yield gpm)

Electric  
 (type power)

(7) electric log \_\_\_\_\_  
 (yes or no)

\_\_\_\_\_ (organization running log)

(8) how well bottom plugged \_\_\_\_\_


DRILLERS REMARKS:

DEPT OF NATURAL RESOURCES  
 BUREAU OF LAND & WATER RESOURCES

SEP 17 1984  
 RECEIVED

If well telescopes please sketch and show depths.

GROUND LEVEL

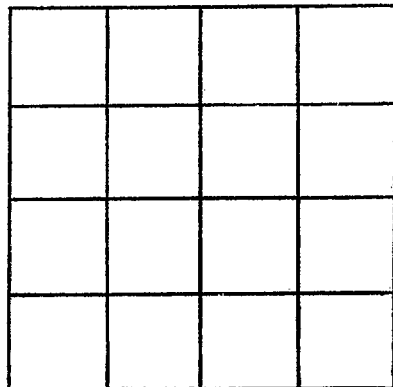

SECTION \_\_\_\_\_

Please indicate well location X.

ADDITIONAL INFORMATION

If more than one screen, show locations of each on sketch.