

MISSISSIPPI DEPARTMENT OF NATURAL RESOURCES

Bureau of Land and Water Resources

Southport Mall

P.O. Box 10631

Jackson, Mississippi 39209

WATER WELL DRILLERS LOG

Tippah
L 2011

8-29-86 19  
date well completed

Medlin Well Drilling  
firm name

Tippah  
county well located

LANDOWNER:	description of formations encountered	from	to
Bon Childs Ripley, MS. (mailing address)			
WELL LOCATION: sec. 5 T. 4 N. R. 5 E 7 miles E of Ripley (distance) (direction) (nearest town)	Sand - Clay 180-240		
WELL PURPOSE: (home irrigation, municipal, industrial)	Sand & Aquifer 240-300		
WELL COMPLETION DATA: (1) diameter (inches) 4" (2) total depth (feet) 300' (3) static water level (feet) 220' below top of ground. (4) casing 4" (material), 300' (depth) (size) If telescope see back. (5) screen 20' (length), 280' (depth to top) 4" (size), PVC (material) (6) pump 3/4 (HP), 12 (yield gpm) Electric (type power) (7) electric log _____ (yes or no) (organization running log) (8) how well bottom plugged Cap			
DRILLERS REMARKS:			


RECEIVED

DEC 15 1986

Department of Natural Resources  
Bureau of Land & Water Resources

If well telescopes please  
sketch and show depths.

GROUND LEVEL

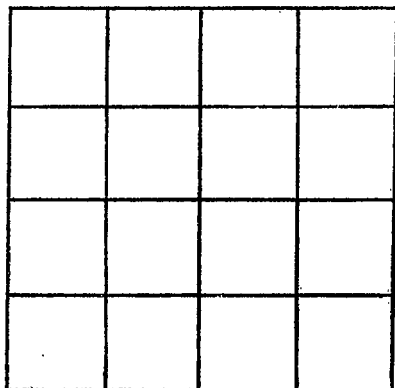

SECTION \_\_\_\_\_

Please indicate well location X.

ADDITIONAL INFORMATION

If more than one screen,  
show locations of each on sketch.