

MISSISSIPPI DEPARTMENT OF NATURAL RESOURCES


Bureau of Land and Water Resources

Southport Mall

P.O. Box 10631

Jackson, Mississippi 39209

WATER WELL DRILLERS LOG

TIPPAH
 L
2012

6.8  
date well completed

1987 Medlin Well Drilling  
firm name

Tippah  
county well located

LANDOWNER:	description of formations encountered	from	to
Gary Lewellen Ripley, MS, 38663 (mailing address)			
WELL LOCATION: 2 1/4 T 4 N R 5 E 9 miles East of Ripley (distance) (direction) (nearest town)	Aquifer	180	210
WELL PURPOSE: (home, irrigation, municipal, industrial)			
WELL COMPLETION DATA: (1) diameter (inches) 4" (2) total depth (feet) 210' (3) static water level (feet) _____ below above top of ground. (4) casing PVC, 200' (material) (depth) (size) if telescope see back. (5) screen 20', 200' (length) (depth to top) (size) (material) (6) pump 1 (HP) 10 (yield gpm) Electric (type power) (7) electric log (yes or no) (organization running log) (8) how well bottom plugged _____			

RECEIVED


SEP 28 1989

Department of Natural Resources  
Bureau of Land & Water Resources

DRILLERS REMARKS:

If well telescopes please  
sketch and show depths.

GROUND LEVEL

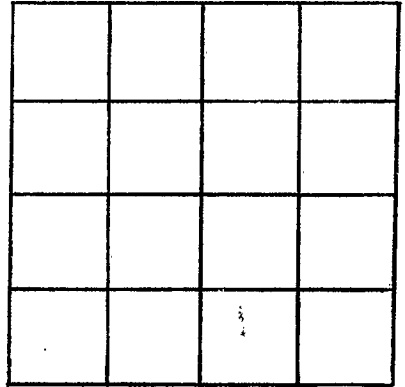

SECTION \_\_\_\_\_

Please indicate well location X.

ADDITIONAL INFORMATION

If more than one screen,  
show locations of each on sketch.