

2-ppah  
M 5  
2-23-68

MISSISSIPPI  
 BOARD OF WATER COMMISSIONERS  
 416 North State Street  
 Jackson, Mississippi 39201

CODED

WATER WELL DRILLERS LOG

Feb. 23 1968 Jumpin Well Co 2-ppah  
 date well completed firm name county well located

LANDOWNER:  
Billy Rogers  
New Albany, Miss  
 (mailing address)

description of formations encountered	from	to
<u>Mixed Clay</u>	<u>0</u>	<u>350</u>
<u>Sand + Rock</u>	<u>350</u>	<u>400</u>

WELL LOCATION:  
 sec. 35 T. 5 N. R. 2 E  
5 miles So. of Blue Mt.  
 (distance) (direction) (nearest town)

WELL PURPOSE: Home  
 (home, irrigation, municipal, industrial)

WELL COMPLETION DATA:

(1) diameter (inches) 4"

(2) total depth (feet) 400 ft.

(3) static water level (feet) 50 below top of ground.

(4) casing PVC, 120  
 (material) (depth)  
None if telescope see back.  
 (size)

(5) screen none, 0-  
 (length) (depth to top)  
 (size) (material)

(6) pump 1/2, 8  
 (HP) (yield gpm)  
Elec.  
 (type power)

(7) electric log No  
 (yes or no)  
 (organization running log)

(8) how well bottom plugged —

CODED


DEC 7 0 1968

DRILLERS REMARKS:

MISS. BD. OF WATER COM.

If well telescopes please sketch and show depths.

GROUND LEVEL

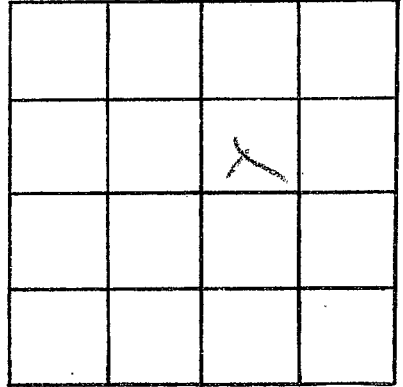

SECTION 35

Please indicate well location X.

ADDITIONAL INFORMATION

If more than one screen, show location's of each on sketch.