

Lippah  
 M6  
 11-8-68

MISSISSIPPI  
 BOARD OF WATER COMMISSIONERS  
 416 North State Street  
 Jackson, Mississippi 39201

CODED

WATER WELL DRILLERS LOG

11-8-1968 date well completed  
 Superior Well Co. firm name  
 Lippah county well located

LANDOWNER:  
 Pete Trozin  
 Myrtle, Miss.  
 (mailing address)

| description of formations encountered | from        | to  |
|---------------------------------------|-------------|-----|
|                                       | Mix of Clay | 0   |
| Sand + Rock                           | 300         | 380 |

WELL LOCATION:  
 sec. 34 T. 5 R. 2 E  
 7 miles NE of Myrtle  
 (distance) (direction) (nearest town)

WELL PURPOSE: Home  
 (home, irrigation, municipal, industrial)

- WELL COMPLETION DATA:
- (1) diameter (inches) 4"
  - (2) total depth (feet) 380
  - (3) static water level (feet) 60 below above top of ground.
  - (4) casing PVC, 120  
 (material), (depth)  
4" if telescope see back.  
 (size)
  - (5) screen 0 0  
 (length) (depth to top)  
0 (size) (material)
  - (6) pump 3/4 8  
 (HP) (yield gpm)  
Elec.  
 (type power)
  - (7) electric log NO  
 (yes or no)  
0  
 (organization running log)
  - (8) how well bottom plugged 0

CODED


DEC 10 1968

DRILLERS REMARKS:

MISS. BD. OF  
 WATER COM.

If well telescopes please sketch and show depths.

GROUND LEVEL

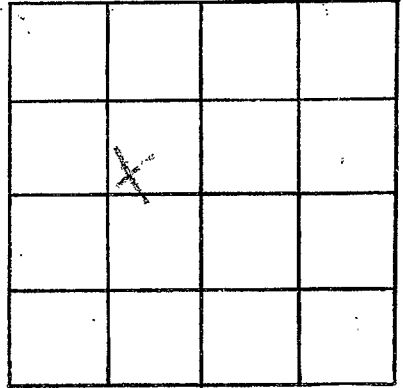

SECTION 34

Please indicate well location X.

ADDITIONAL INFORMATION

If more than one screen,  
show locations of each on sketch.