

Rtn 7/23/69

MISSISSIPPI  
BOARD OF WATER COMMISSIONERS  
416 North State Street  
Jackson, Mississippi 39201

CODED

WATER WELL DRILLERS LOG

Lippah  
M 8  
1-8-69

18 1969 J.F. McAllen Lippah  
date well completed firm name county/well located

LANDOWNER:	description of formations encountered	from	to
T.H. Henderson	White clay	0	20
Blue mts, miss City	Blue "	20	106
(mailing address) OK	White sand	106	119
WELL LOCATION:	Blue clay	112	210
sec. 3 T. 5 N. R. 3 E	Rock	114	130
8/11/69	Sand	130	138
No. West miles 2. of Blue mts	Blue Clay	138	160
(distance) (direction) (nearest town)	Rock + Sand	160	280

WELL PURPOSE: Home  
(home, irrigation, municipal, industrial)

WELL COMPLETION DATA:

- (1) diameter (inches) 4"
- (2) total depth (feet) 280
- (3) static water level (feet) 60 below above top of ground.
- (4) casing pl 120  
(material) (depth)
- \_\_\_\_\_ if telescope see back.  
(size)
- (5) screen \_\_\_\_\_  
(length) (depth to top)
- \_\_\_\_\_ (size) \_\_\_\_\_ (material)
- (6) pump 3/4 10  
(HP) (yield gpm)
- E  
(type power)
- (7) electric log \_\_\_\_\_  
(yes or no)
- \_\_\_\_\_ (organization running log)
- (8) how well bottom plugged \_\_\_\_\_


Location Needed.  
OK 7-16-69

JUL 24 1969  
Mississippi Board of Water Commissioners

DRILLERS REMARKS:

If well telescopes please sketch and show depths.

GROUND LEVEL

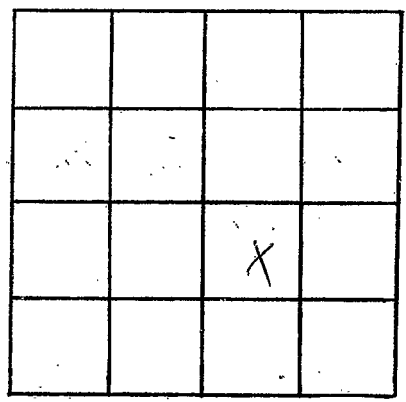

SECTION \_\_\_\_\_

Please indicate well location X.

ADDITIONAL INFORMATION

If more than one screen, show locations of each on sketch.