

TIPPAH
M 12
4-19-72

MISSISSIPPI
BOARD OF WATER COMMISSIONERS
416 North State Street
Jackson, Mississippi 39201

\$ 600 00
30 00
CODED 00

WATER WELL DRILLERS LOG

4 19 19 72 J T Mellie Tippah
date well completed firm name county well located

LANDOWNER: Terry Carter	description of formations encountered	from	to
Blue Mt R#1.			
(mailing address)	Clay	0	18
	Rock	18	77
	Clay	29	140
	Rock & sand	240	260

WELL LOCATION:
sec. 25 T 5 N R 2 E
3 miles SW of Blue Mt
(distance) (direction) (nearest town)

WELL PURPOSE:
(home, irrigation, municipal, industrial)

- WELL COMPLETION DATA:
- (1) diameter (inches) 4
 - (2) total depth (feet) 26
 - (3) static water level (feet) 46 below top of ground.
 - (4) casing P 80 (material) (depth)
(size) if telescope see back.
 - (5) screen (length) (depth to top)
(size) (material)
 - (6) pump 1/2 5 (HP) (yield gpm)
E (type power)
 - (7) electric log (yes or no)
(organization running log)
 - (8) how well bottom plugged

CODED


MAY 9 - 1972

MISS. BD. OF
WATER COMR.

DRILLERS REMARKS:

If well telescopes please sketch and show depths.

GROUND LEVEL

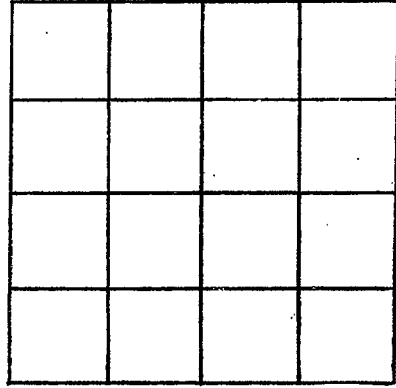

SECTION _____

Please indicate well location X.

ADDITIONAL INFORMATION

A series of horizontal lines providing space for additional information.

If more than one screen, show locations of each on sketch.