

**MISSISSIPPI  
BOARD OF WATER COMMISSIONERS**  
416 North State Street  
Jackson, Mississippi 39201

**WATER WELL DRILLERS LOG**

**Tippah**  
**M13**  
**5-16-70**

5-16 19 70 JT Medlin Tippah  
date well completed firm name county well located

**LANDOWNER:** Richard Wade  
Blue Mt  
(mailing address) 216

**WELL LOCATION:**  
sec. 1 T. 5 N. R. 2 E  
1 miles W of Blue Mt  
(distance) (direction) (nearest town)

**WELL PURPOSE:**  
(home, irrigation, municipal, industrial)

**WELL COMPLETION DATA:**

- (1) diameter (inches) 4
- (2) total depth (feet) 410
- (3) static water level (feet) 120 below top of ground.
- (4) casing P 215  
(material) (depth)  
(size) if telescope see back.
- (5) screen \_\_\_\_\_  
(length) (depth to top)  
(size) (material)
- (6) pump 34 6  
(HP) (yield gpm)  
E  
(type power)
- (7) electric log yes or no  
(organization running log)
- (8) how well bottom plugged \_\_\_\_\_


description of formations encountered	from to	
	feet	feet
Red Clay	0	4
White "	4	18
Blue "	18	40
Blue scaptonel.	40	225
Blue clay	225	235
SAND	235	242
Blue clay	242	262
Rock + "	262	294
Blue clay	294	317
Rock + Sand	317	410

JUN 3 1970

**DRILLERS REMARKS:**

If well telescopes please  
sketch and show depths.

GROUND LEVEL

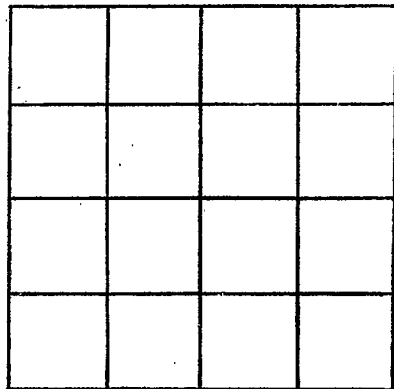

SECTION \_\_\_\_\_

Please indicate well location X.

ADDITIONAL INFORMATION

If more than one screen,  
show locations of each on sketch.