

TIPPAAH
M 14
12-18-70

MISSISSIPPI
BOARD OF WATER COMMISSIONERS
416 North State Street
Jackson, Mississippi 39201

CODED

WATER WELL DRILLERS LOG

12/18 1970 J T Medlin Tippah
date well completed firm name county/well located

LANDOWNER: Jarvis K. Rutledge

R# 1

Blue mtn
(mailing address)

description of formations encountered

Blue clay
Rock
Sand

from	to
<u>0</u>	<u>18</u>
<u>18</u>	<u>300</u>
<u>300</u>	<u>320</u>
<u>320</u>	<u>367</u>

WELL LOCATION:

sec 36 T 5 N R 2 E
4 miles S Blue Mtn
(distance) (direction) (nearest town)

WELL PURPOSE:

(home, irrigation, municipal, industrial)

WELL COMPLETION DATA:

- (1) diameter (inches) 4
- (2) total depth (feet) 367
- (3) static water level (feet) 22 below top of ground.
- (4) casing P 82
(material) (depth)
(size) if telescope see back.
- (5) screen _____
(length) (depth to top)
(size) (material)
- (6) pump 3/4 5
(HP) (yield gpm)
E
(type power)
- (7) electric log _____
(yes or no)
(organization running log)
- (8) how well bottom plugged pl

CODED


JAN 4 1971

MISS. BD. OF
WATER COMM.

DRILLERS REMARKS:

If well telescopes please sketch and show depths.

GROUND LEVEL

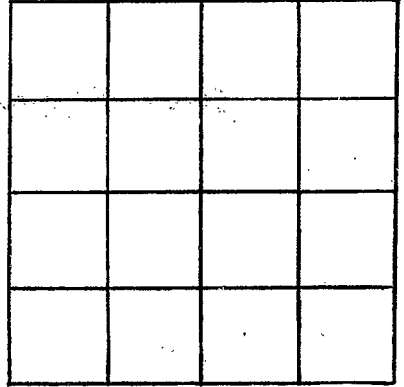

SECTION _____

Please indicate well location X.

ADDITIONAL INFORMATION

If more than one screen,
show locations of each on sketch.