

TIPPAH
 MISS.
 3-30-71

MISSISSIPPI
 BOARD OF WATER COMMISSIONERS
 416 North State Street
 Jackson, Mississippi 39201

CODED

WATER WELL DRILLERS LOG

3-30-71 date well completed
 J T Medlin firm name
 Tippah county well located

LANDOWNER:
 Lee Russell Gray
 Blue R #1
 (mailing address)

description of formations encountered	from	to
Clay	0	23
Blue s	23	160
Rock	160	190
Sand	190	209
Blue sand	209	219
	219	260

WELL LOCATION:
 sec. 25 T. 5 N. R. 2 E
 3 miles S of Blue Mt.
 (distance) (direction) (nearest town)

WELL PURPOSE:
 (home, irrigation, municipal, industrial)

- WELL COMPLETION DATA:
- (1) diameter (inches) 4
 - (2) total depth (feet) 260
 - (3) static water level (feet) 40 below top of ground.
 - (4) casing P 100 (material) (depth)
 - (size) if telescope see back.
 - (5) screen (length) (depth to top)
 - (size) (material)
 - (6) pump 7.5 10 (HP) (yield gpm)
 - E (type power)
 - (7) electric log (yes or no)
 - (organization running log)
 - (8) how well bottom plugged

CODED


APR - 6 1971

MISS. Bd. Of
 WATER COMMISSIONERS

DRILLERS REMARKS:

If well telescopes please sketch and show depths.

GROUND LEVEL

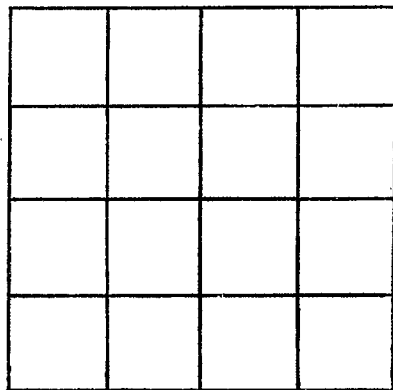

SECTION _____

Please indicate well location X.

ADDITIONAL INFORMATION

If more than one screen,
show locations of each on sketch.