

TIPPAH
M 18
9-18-71

MISSISSIPPI
BOARD OF WATER COMMISSIONERS
416 North State Street
Jackson, Mississippi 39201

\$ 800.00
40.00
\$ 840.00

WATER WELL DRILLERS LOG

CODED

9-18 1971 JT Medley Tippah
date well completed firm name county well located

LANDOWNER:	description of formations encountered	from	to
WAYNE VICTOR R# 2 Blue Mt (mailing address)	Memphis Tenn Clay Blue Rock & clay Rock & sand	24 24 325 360	24 325 360 450

WELL LOCATION:
sec. 34 T 5 N R 2 E
4 miles S.W. of Blue Mt
(distance) (direction) (nearest town)

WELL PURPOSE:
(home, irrigation, municipal, industrial)

- WELL COMPLETION DATA:
- (1) diameter (inches) 4
 - (2) total depth (feet) 430
 - (3) static water level (feet) 80 below top of ground.
 - (4) casing P 120 (material) (depth)
(size) if telescope see back.
 - (5) screen 0 (length) (depth to top)
(size) (material)
 - (6) pump 5 8 (HP) (yield gpm)
E (type power)
 - (7) electric log (yes or no)

CODED


OCT 6 - 1971

MISS. Bd. OF
WATER COMM.

DRILLERS REMARKS:

If well telescopes please sketch and show depths.

GROUND LEVEL

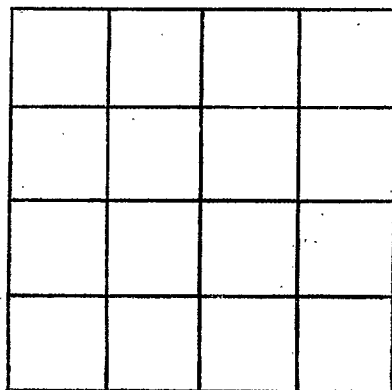

SECTION _____

Please indicate well location X.

ADDITIONAL INFORMATION

If more than one screen, show locations of each on sketch.