

TIPPAH
M 20
12-4-71
 MISS. DIV. OF
 WATER COMM.

MISSISSIPPI
 BOARD OF WATER COMMISSIONERS
 416 North State Street
 Jackson, Mississippi 39201

\$ 650.00
 Tel 3250
 682.50

WATER WELL DRILLERS LOG




12 4 1971 date well completed
 J. J. Modlin firm name
 Tippah county well located

LANDOWNER:	description of formations encountered	from	to
H. S. Graham	W. clay	0	27
Blue Mtn R# 1.	Bl. "	27	145
	Rock & clay	145	185
	Bl. "	185	205
	Rock & sand	205	300

WELL LOCATION:
 sec. 25 T 3 R 2 E
 3 miles S.W. of Blue Mtn
 (distance) (direction) (nearest town)

WELL PURPOSE:
 (home, irrigation, municipal, industrial)


- WELL COMPLETION DATA:**
- (1) diameter (inches) 4
 - (2) total depth (feet) 300
 - (3) static water level (feet) 40 below top of ground.
 - (4) casing P 90 (material), (depth)
 (size) if telescope see back.
 - (5) screen (length), (depth to top)
 (size), (material)
 - (6) pump 5/8 (HP), 3 (yield gpm)
 E (type power)
 - (7) electric log (yes or no)
 (organization running log)
 - (8) how well bottom plugged

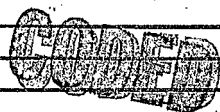

DRILLERS REMARKS:

If well telescopes please sketch and show depths.

GROUND LEVEL

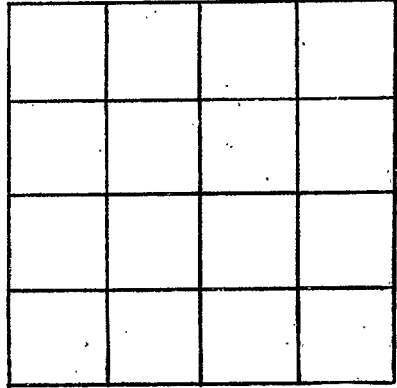

SECTION _____

Please indicate well location X.

ADDITIONAL INFORMATION

If more than one screen,
show locations of each on sketch.