

TIPPAH
MAY 29 1972
12-6-71
 WATER COM. 11

MISSISSIPPI BOARD OF WATER COMMISSIONERS
 416 North State Street
 Jackson, Mississippi 39201

650.00
 3250
 682.50

WATER WELL DRILLERS LOG

12-6-71 date well completed 1971 firm name J-T Medlin county well located Tippah

LANDOWNER	description of formations encountered	from	to
Jamel Sarban	W. clay	0	27
Blue water Main R#1	Rock & clay	27	145
38610 G.H. Sarban	Blue " "	145	183
(mailing address)	Rock & sand	183	208
		208	300

WELL LOCATION:
 sec. 25 T 5 N R 2 E
 3 miles S.W. of Blue water
 (distance) (direction) (nearest town)

WELL PURPOSE:
 (home, irrigation, municipal, industrial)


- WELL COMPLETION DATA:**
- (1) diameter (inches) 4
 - (2) total depth (feet) 300
 - (3) static water level (feet) 48 below above top of ground.
 - (4) casing P 90
 (material) (depth)
 (size) if telescope see back.
 - (5) screen _____
 (length) (depth to top)
 (size) (material)
 - (6) pump 3/4 5
 (HP) (yield gpm)
E
 (type power)
 - (7) electric log _____
 (yes or no)
 (organization running log)
 - (8) how well bottom plugged _____

DRILLERS REMARKS:

CODER

If well telescopes please sketch and show depths.

GROUND LEVEL

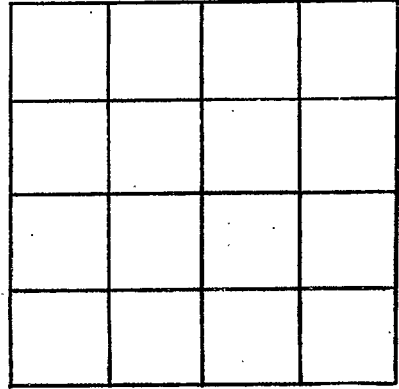

SECTION _____

Please indicate well location X.

ADDITIONAL INFORMATION

If more than one screen,
show locations of each on sketch.