

TIPPAH
M 22
6-9-72

MISSISSIPPI
BOARD OF WATER COMMISSIONERS
416 North State Street
Jackson, Mississippi 39201

800.00
4300
845.00

WATER WELL DRILLERS LOG

6-9 1972 J T Medlin Tippah
Date well completed firm name county well located

LANDOWNER:	description of formations encountered	from	to
R. L. Lajoie	S. Lag	0	350
Rutherford	Rock & Sand	350	400
Blue water			
(mailing address)			

WELL LOCATION:
sec. 14 5 N R 2 E
3 miles W of Bluewater
(distance) (direction) (nearest town)

WELL PURPOSE:
(home, irrigation, municipal, industrial)

- WELL COMPLETION DATA:
- (1) diameter (inches) 4
 - (2) total depth (feet) 410
 - (3) static water level (feet) 90 below top of ground.
 - (4) casing P 100 (material) (depth)
 - (size) If telescope see back.
 - (5) screen (length) (depth to top)
 - (size) (material)
 - (6) pump 1/2 6 (HP) (yield gpm)
 - (type power)
 - (7) electric log (yes or no)
 - (organization running log)
 - (8) how well bottom plugged


DRILLERS REMARKS:

MAR 19 1972

MISS. BD.
WATER COMMISSIONERS

If well telescopes please sketch and show depths.

GROUND LEVEL

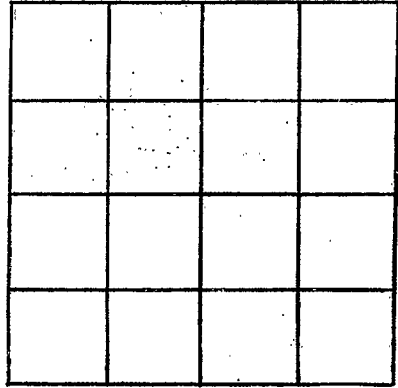

SECTION _____

Please indicate well location X.

ADDITIONAL INFORMATION

If more than one screen, show locations of each on sketch.