

TIPPAH
M 24
5-17-71
5-17-71
date well completed 19

MISSISSIPPI
BOARD OF WATER COMMISSIONERS
416 North State Street
Jackson, Mississippi 39201


WATER WELL DRILLERS LOG

James Earl Willey Tippah
firm name county well located

LANDOWNER:	description of formations encountered	from	to
<i>Doby Cobb</i> <i>Myrtle Miss.</i> (mailing address)	<i>mixd clay</i>	0	300
WELL LOCATION: sec. <i>34</i> T. <i>5</i> S. R. <i>2</i> E <i>4</i> miles <i>N.E.</i> of <i>Myrtle</i> (distance) (direction) (nearest town)	<i>Int s rock</i>	300	380
WELL PURPOSE: <i>home</i> (home, irrigation, municipal, industrial)			
WELL COMPLETION DATA: (1) diameter (inches) <i>4"</i> (2) total depth (feet) <i>380</i> (3) static water level (feet) <i>60</i> below above top of ground. (4) casing <i>PVC 120</i> <i>4"</i> (material) (depth) (size) If telescope see back. (5) screen <i>0</i> <i>0</i> (length) (depth to top) <i>0</i> (size) (material) (6) pump <i>3/4</i> <i>8</i> (HP) (yield gpm) <i>Elee</i> (type power) (7) electric log <i>no</i> (yes or no) (organization running log) <i>0</i> (8) how well bottom plugged <i>0</i>			
DRILLERS REMARKS:	MAY 20 1972		

If well telescopes please sketch and show depths.

GROUND LEVEL

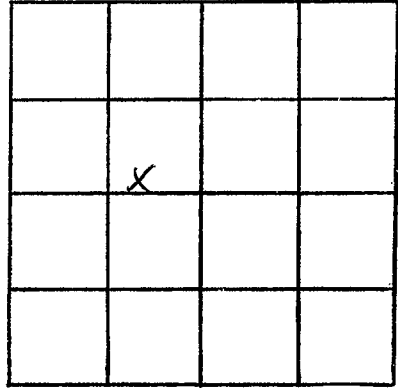

SECTION 3f

Please indicate well location X.

ADDITIONAL INFORMATION

Lined area for additional information.

If more than one screen, show locations of each on sketch.