

TIPPANH
M 29
3-16-73

MISSISSIPPI
BOARD OF WATER COMMISSIONERS
416 North State Street
Jackson, Mississippi 39201

CODED 35.00
36.75
Total 71.75

WATER WELL DRILLERS LOG

316 date well completed 19 28 firm name J F Medlin county well located Tippah

LANDOWNER: 027 ell
Reelfoot
Blue Mills
(mailing address)

| description of formations encountered | from | to |
|---------------------------------------|------|-----|
| clay | 0 | 26 |
| blue flint | 26 | 145 |
| rock & clay | 145 | 175 |
| rock & sand | 175 | 370 |

WELL LOCATION:
sec. 12 T. 5 N. R. 2 E
1/4 miles W of Blue Mills
(distance) (direction) (nearest town)

WELL PURPOSE:
(home, irrigation, municipal, industrial)

- WELL COMPLETION DATA:
- (1) diameter (inches) 4 3/4
 - (2) total depth (feet) 370
 - (3) static water level (feet) 60 below above top of ground.
 - (4) casing (material) P (depth) 110
(size) if telescope see back.
 - (5) screen (length) _____ (depth to top) _____
(size) (material)
 - (6) pump (HP) 1 (yield gpm) 6
(type power) C
 - (7) electric log (yes or no) _____
(organization running log) _____
 - (8) how well bottom plugged _____


CODED

DRILLERS REMARKS:

MISSISSIPPI
DEPT. OF AGRICULTURE

If well telescopes please
sketch and show depths.

GROUND LEVEL

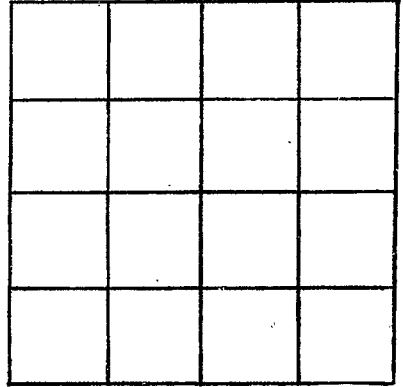

SECTION _____

Please indicate well location X.

ADDITIONAL INFORMATION

If more than one screen,
show locations of each on sketch.