

TIPPAH
M 2002

MISSISSIPPI
BOARD OF WATER COMMISSIONERS
416 North State Street
Jackson, Mississippi 39201

WATER WELL DRILLERS LOG

5-3-78 date well completed
Bryants Well Drilling firm name
Tipah county well located

LANDOWNER: Hubert Earl
Bruce W. M. Miss (mailing address)

description of formations encountered	from	to
Clay	0	40
Clay & Sand	40	85
Bl. Clay	85	200
Sand & Gravel	200	275

WELL LOCATION:
sec. 3 T. 8 N. R. 2 E
6 miles South of Blue Mtn.
(distance) (direction) (nearest town)

WELL PURPOSE: Home
(home, irrigation, municipal, industrial)

- WELL COMPLETION DATA:
- (1) diameter (inches) 4"
 - (2) total depth (feet) 275
 - (3) static water level (feet) 50 below top of ground.
 - (4) casing (material) p/los (depth) 110 ft.
 - (size) if telescope see back.
 - (5) screen (length) (depth to top)
 - (size) (material)
 - (6) pump 2 sub (HP) 10 (yield gpm)
 - 3 hp (type power)
 - (7) electric log (yes or no)
 - (organization running log)
 - (8) how well bottom plugged open


RECEIVED
AUG - 3 1978

DRILLERS REMARKS:

MISS. BD. OF WATER COM.

If well telescopes please sketch and show depths.

GROUND LEVEL

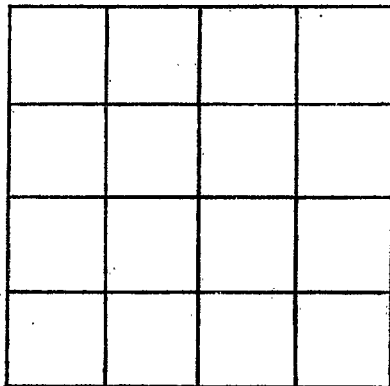

SECTION _____

Please indicate well location X.

ADDITIONAL INFORMATION

If more than one screen,
show locations of each on sketch.