

TIPPRAH  
M 2003

MISSISSIPPI  
BOARD OF WATER COMMISSIONERS  
416 North State Street  
Jackson, Mississippi 39201

WATER WELL DRILLERS LOG

4-18-78 date well completed 19 Bryant's Well Drilling firm name Tippah county well located

LANDOWNER: James Belofard  
Blue Mtn Miss  
(mailing address)

description of formations encountered	from	to
Clay Muds	0	46
Blue Clay	45	230
Sand & Rock	230	300

WELL LOCATION:  
sec 3 T 5 N R 2 E ?  
4 miles South of Blue Mtn  
(distance) (direction) (nearest town)

WELL PURPOSE: Home  
(home, irrigation, municipal, industrial)


- WELL COMPLETION DATA:
- (1) diameter (inches) 4"
  - (2) total depth (feet) 300
  - (3) static water level (feet) 25 below top of ground.
  - (4) casing Pvc 120ft.  
(material) (depth)
  - (size) if telescope see back.
  - (5) screen (length) (depth to top)
  - (size) (material)
  - (6) pump 2 1/2 HP 10  
(HP) (yield gpm)
  - Elec  
(type power)
  - (7) electric log (yes or no)
  - (organization running log)
  - (8) how well bottom plugged open

DRILLERS REMARKS:

RECEIVED  
AUG - 3 1978

If well telescopes please sketch and show depths.

GROUND LEVEL

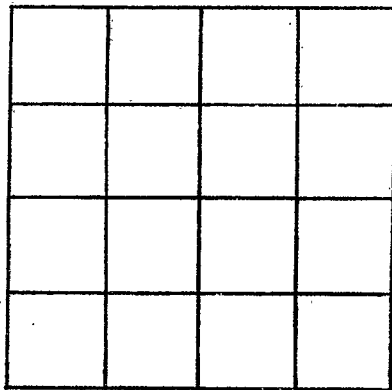

SECTION \_\_\_\_\_

Please indicate well location X.

ADDITIONAL INFORMATION

If more than one screen,  
show locations of each on sketch.