

Tippah
 M, 2000
 9/18/79
 9/18

MISSISSIPPI
 BOARD OF WATER COMMISSIONERS
 416 North State Street
 Jackson, Mississippi 39201

WATER WELL DRILLERS LOG

date well completed

firm name

county well located

19 79 J T Medley TIPPAAH

LANDOWNER:

Joe B. Williams

Blue mtn.

(mailing address)

description of formations encountered

from

to

Clay 0 380
 Rock & sand 380 460

WELL LOCATION:

sec. 11 T 5 N R 2 E
 S W
 2 miles W of Blue mtn.
 (distance) (direction) (nearest town)

WELL PURPOSE:

(home, irrigation, municipal, industrial)

WELL COMPLETION DATA:

- (1) diameter (inches) 4
 (2) total depth (feet) 460
 (3) static water level (feet) 160 below top of ground.
 (4) casing P 2.16 (material) (depth)

(size) If telescope see back.

- (5) screen (length) (depth to top)

(size) (material)

- (6) pump 3/4 8 (HP) (yield gpm)

(type power)

- (7) electric log (yes or no)

(organization running log)


- (8) how well bottom plugged open

10 ft 79
 JTW

DRILLERS REMARKS:

If well telescopes please sketch and show depths.

GROUND LEVEL

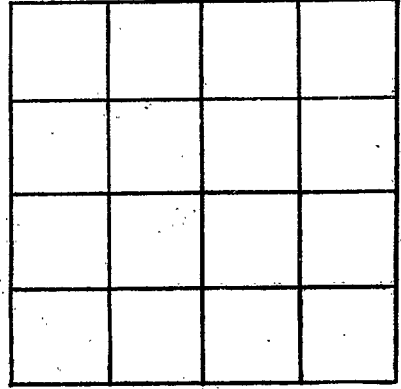

SECTION _____

Please indicate well location X.

ADDITIONAL INFORMATION

If more than one screen, show locations of each on sketch.