

MISSISSIPPI DEPARTMENT OF NATURAL RESOURCES

Bureau of Land and Water Resources

Southport Mall

P.O. Box 10631

Jackson, Mississippi 39209

WATER WELL DRILLERS LOG

Jipah
M
2009

6-10-1982

ST medlin

hppak

date well completed

firm name

county well located

LANDOWNER:

Marble Spears

Hwy 2 Blue Mt W
(mailing address)

WELL LOCATION:

sec. 14 T 5 N R 2 E
3 miles W Blue Mt W
(distance) (direction) of (nearest town)

description of formations encountered

from to

Clay - sandstone 0 - 100

Clay - Rock 100 - 200

lime rock 200 - 300

sand - shell 300 - 400

WELL PURPOSE:

(home, irrigation, municipal, industrial)

WELL COMPLETION DATA:

- (1) diameter (inches) 4
- (2) total depth (feet) 400
- (3) static water level (feet) 100 below above top of ground.
- (4) casing PVC 160
(material) (depth)

_____ if telescope see back.
(size)

- (5) screen _____
(length) (depth to top)

_____ (size) _____ (material)

- (6) pump 1/2 10
(HP) (yield gpm)

Etc
(type power)

- (7) electric log (yes or no) _____

_____ (organization running log)

- (8) how well bottom plugged _____

DRILLERS REMARKS:


DEPT. OF NATURAL RESOURCES
BUREAU OF LAND & WATER RESOURCES

JUN 28 1982

RECEIVED

If well telescopes please sketch and show depths.

GROUND LEVEL

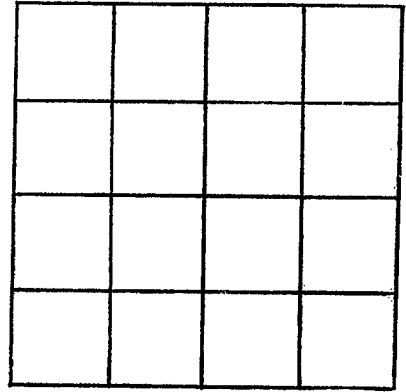

SECTION _____

Please indicate well location X.

ADDITIONAL INFORMATION

If more than one screen,
show locations of each on sketch.