

MISSISSIPPI DEPARTMENT OF NATURAL RESOURCES

Bureau of Land and Water Resources

Southport Mall

P.O. Box 10631

Jackson, Mississippi 39209

WATER WELL DRILLERS LOG

Jippan
M
2010

3-20- 1982 J.T. Medlin Jippan
date well completed firm name county well located

LANDOWNER:
L. G. Grey
R#2 Blue MAN MS.
(mailing address)

description of formations encountered	from	to
<u>top soil - clay</u>	<u>0</u>	<u>80</u>
<u>Blue clay</u>	<u>80</u>	<u>180</u>

WELL LOCATION:
sec 35 5 N R 2 W
3 miles S of Blue MAN
(distance) (direction) (nearest town)

description of formations encountered	from	to
<u>CLAY - Lime Rock -</u>	<u>180</u>	<u>340</u>
<u>SAND -</u>		

WELL PURPOSE:
 (home) irrigation, municipal, industrial

WELL COMPLETION DATA:

(1) diameter (inches) 4

(2) total depth (feet) 340

(3) static water level (feet) 40 below above top of ground.

(4) casing PVC 120
(material) (depth)

 if telescope see back.
(size)

(5) screen
(length) (depth to top)

(size) (material)

(6) pump 1/2 10
(HP) (yield gpm)

Ele
(type power)

(7) electric log
(yes or no)

(organization running log)

(8) how well bottom plugged

DRILLERS REMARKS:


DEPT. OF NATURAL RESOURCES
BUREAU OF LAND & WATER RESOURCES

JUN 28 1982

RECEIVED

If well telescopes please sketch and show depths.

GROUND LEVEL

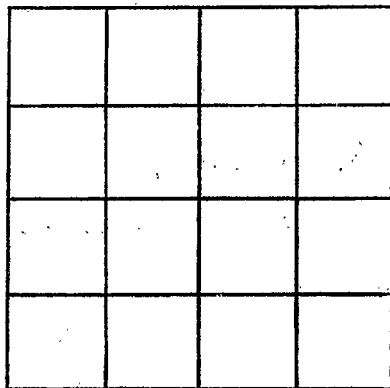

SECTION _____

Please indicate well location X.

ADDITIONAL INFORMATION

If more than one screen, show locations of each on sketch.