

MISSISSIPPI DEPARTMENT OF NATURAL RESOURCES

Bureau of Land and Water Resources

Southport Mall

P.O. Box 10631

Jackson, Mississippi 39209

WATER WELL DRILLERS LOG

Tippah
M 2011

11-2- 1982 V.T. Mall Tippah
 date well completed firm name county well located

LANDOWNER:
Ethel Childs
Highway 2 W. Blue Mtn
 (mailing address)

description of formations encountered	from	to
<u>Deep sand -</u>	<u>17</u>	<u>120</u>
<u>Rock</u>		
<u>Clay -</u>	<u>120</u>	<u>230</u>
<u>sand - clay</u>	<u>230</u>	<u>340</u>
<u>Rock.</u>		

WELL LOCATION:
 sec. 3 T 5 N R 2 E
3 miles W Blue Mtn
 (distance) (direction) (nearest town)

WELL PURPOSE:
 (home-irrigation, municipal, industrial)

WELL COMPLETION DATA:
 (1) diameter (inches) 4
 (2) total depth (feet) 340
 (3) static water level (feet) 120 below top of ground
 (4) casing Pvc 160
 (material) (depth)
 (size) if telescope see-back.
 (5) screen _____
 (length) (depth to top)
 (size) (material)
 (6) pump 1/2 9
 (HP) (yield gpm)
ele
 (type power)
 (7) electric log _____
 (yes or no)
 (organization running log)
 (8) how well bottom plugged _____

DRILLERS REMARKS:


DEPT. OF NATURAL RESOURCES
 BUREAU OF LAND & WATER RESOURCES

NOV 22 1982

RECEIVED

If well telescopes please sketch and show depths.

GROUND LEVEL

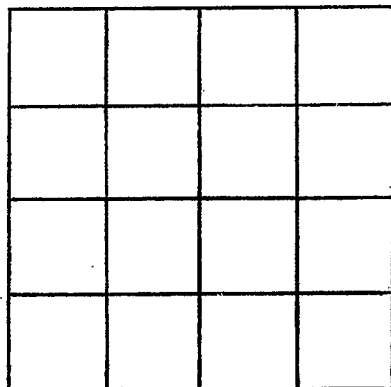

SECTION _____

Please indicate well location X.

ADDITIONAL INFORMATION

If more than one screen, show locations of each on sketch.