

MISSISSIPPI DEPARTMENT OF NATURAL RESOURCES

Bureau of Land and Water Resources

Southport Mall

P.O. Box 10631

Jackson, Mississippi 39209

WATER WELL DRILLERS LOG

TIPPANH
M 2012

DEC 1986
date well completed

LEEPER DRILLING
firm name

TIPPANH
county well located

LANDOWNER: HELL CREEK FARM
RT 1 Blue Mountain

(mailing address)

WELL LOCATION:

sec. 26 T 5 N R 2 E
4 miles SW of BLUE MOUNTAIN
(distance) (direction) (nearest town)

WELL PURPOSE: HOME
(home, irrigation, municipal, industrial)

WELL COMPLETION DATA:

- (1) diameter (inches) 4"
- (2) total depth (feet) 342'
- (3) static water level (feet) 90 (below) above top of ground.
- (4) casing PVC 200' (material) (depth)
4" (size) If telescope see back.
- (5) screen NONE (length) (depth to top)
(size) (material)
- (6) pump 1 (HP) 10 (yield gpm)
ELEC (type power)
- (7) electric log NO (yes or no)
(organization running log)
- (8) how well bottom plugged OPEN

description of formations encountered

from to

TOP CLAY	0	20
BLUE CLAY	20	80
ROCK + SAND	80	160
Blue clay	160	280
SAND	280	342


RECEIVED
DEC 24 1986

Department of Natural Resources
Bureau of Land & Water Resources

DRILLERS REMARKS:

If well telescopes please sketch and show depths.

GROUND LEVEL

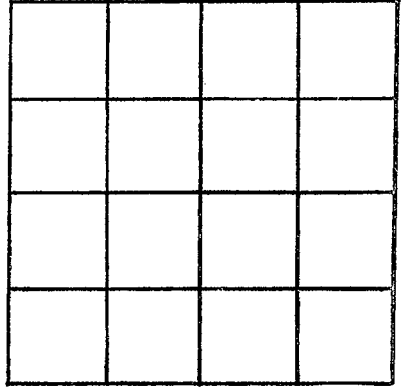

SECTION _____

Please indicate well location X.

ADDITIONAL INFORMATION

If more than one screen,
show locations of each on sketch.